




DATE \_\_\_\_\_

TOWN OF LEXINGTON — BOARD OF PUBLIC WORKS

WATER DIVISION

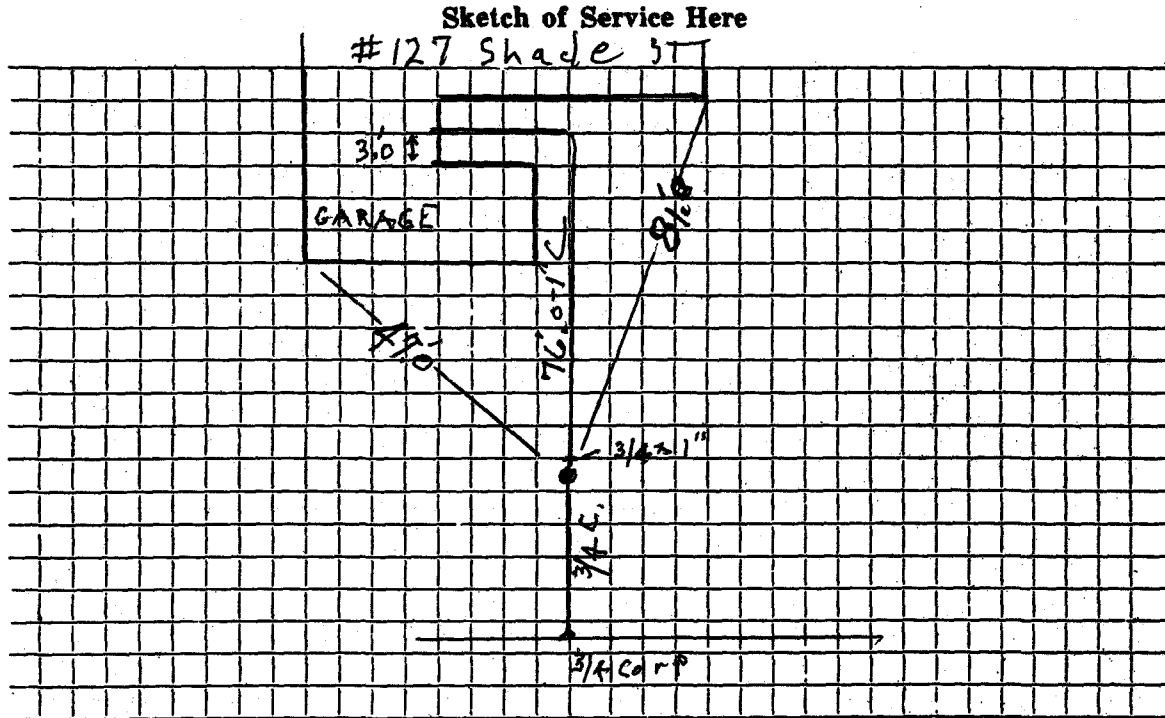

Connection made in ..... Street.

Work completed 11/15/05... J. McLaughlin...

Remarks: .....  
.....  
.....