

Name Frank C. Danforth

Service No. 2437

Address Watertown Electric Company, Watertown, Massachusetts

Location 129 Shade Street, Lexington

Kind of Pipe

Size

Size of Main

~~Repairs-Renewal~~ - New Service

Location

Date 1938	Material	Amount	Total	Date	Location	Amount
Aug. 5,	2 hrs. @ 60¢		1 20	July 30, 1938	Deposited	30 00
2009-27-38	38' 3/4" C. Tubing @ 20¢		7 60	Feb 13, 1939	abated	7 66
	1 3/4" S. & W.		3 75	9-18-'61	Repair	
	Trucking 2 hrs. @ 75¢		1 50		6' 3/4" Copper	
			14 05		1 3/4" C.-3 Part UNION	
	<u>Flat Rate:</u>					
	38' @ 50¢	19 00	19 00			
	Trench Repairs	11 66	(18 66)			
		30 00	\$37 66			

Hadley Press, Inc., Lexington

note:
 Trench repairs figured incorrectly.
 Labor allowed the \$11.66. Abate \$7.66 additional charge.

Bel. sent. Manufact. 1/23/38

TOWN OF LEXINGTON—BOARD OF PUBLIC WORKS

WATER DIVISION

The undersigned applies for a supply of water at No. 129 Shade St. and hereby agrees to comply with the rules and regulations as now, or at any future time, established by the Board of Selectmen.

Am't. of Estimate \$ 30.00

Am't. Paid \$ _____

Builder Wm L. Kinney


Owner

Frank C. Danforth

Address

18 Tyler Ave
W. Medford, Mass

Sketch of Service Here

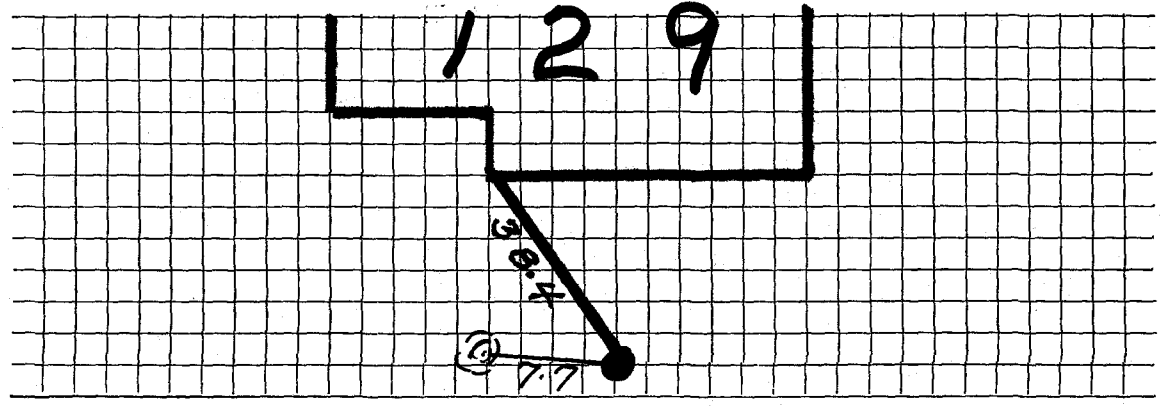

Connection made in _____ Street.

Work completed _____ 19

Remarks: