

Name John A. Rodes

Service No. ~~58~~ 2438

Address 25 Commonwealth Road, Water-town, Mass.

#6468

131 Shade St.

Location

131 Shade Street

Kind of Pipe

Size

Size of Main

Repair—Renewal—New Service

Location

Date
1939

Material

Amount

Total

Date

Amount

Sept. 4

2 hrs. @ 60¢

1 20

Aug. 30, 1939. Deposited

75.00

*Comp
10/30/39.*

42' 3/4" Copper tubing @ 15¢

6 30

1 3/4" S. & W.

2 10

2 hrs. trucking @ 75¢

1 50

Trench repairs

15 00

26 10

Flat Rate: Charge \$25.00

Labor

Hadley Press, Inc., Lexington

DATE August 30 19

\$ 25

TOWN OF LEXINGTON—BOARD OF PUBLIC WORKS

WATER DIVISION

The undersigned applies for a supply of water at No. 131 Shade St. and hereby agrees to comply with the rules and regulations as now, or at any future time, established by the Board of Selectmen.

Am't. of Estimate \$ 25⁰⁰

Owner

John A. Rodes
Rodes


Am't. Paid \$ _____

Address

52 Commonwealth Rd
Watertown

Builder _____

Sketch of Service Here

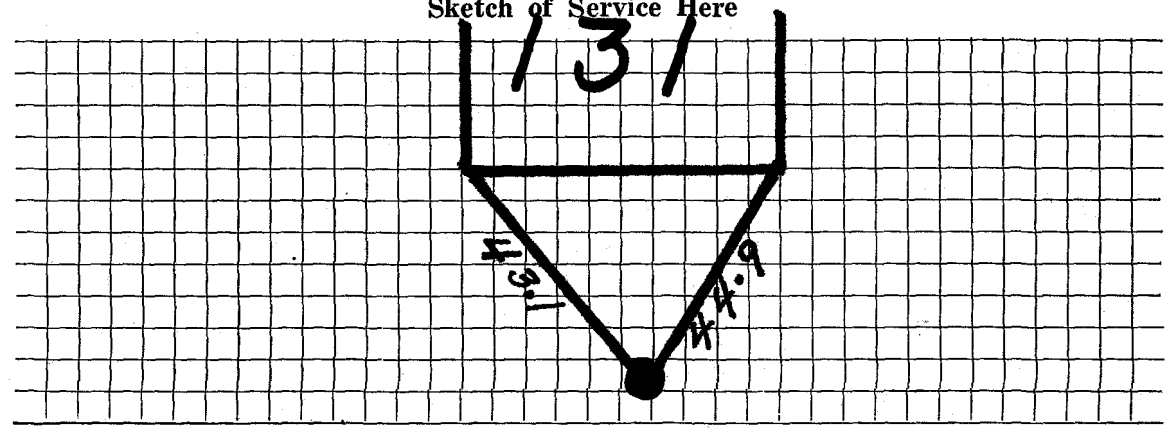

Connection made in _____ Street. Work completed _____ 19

Remarks: