


DATE _____

TOWN OF LEXINGTON — BOARD OF PUBLIC WORKS

WATER DIVISION

Sketch of Service Here
SET Back of Lot

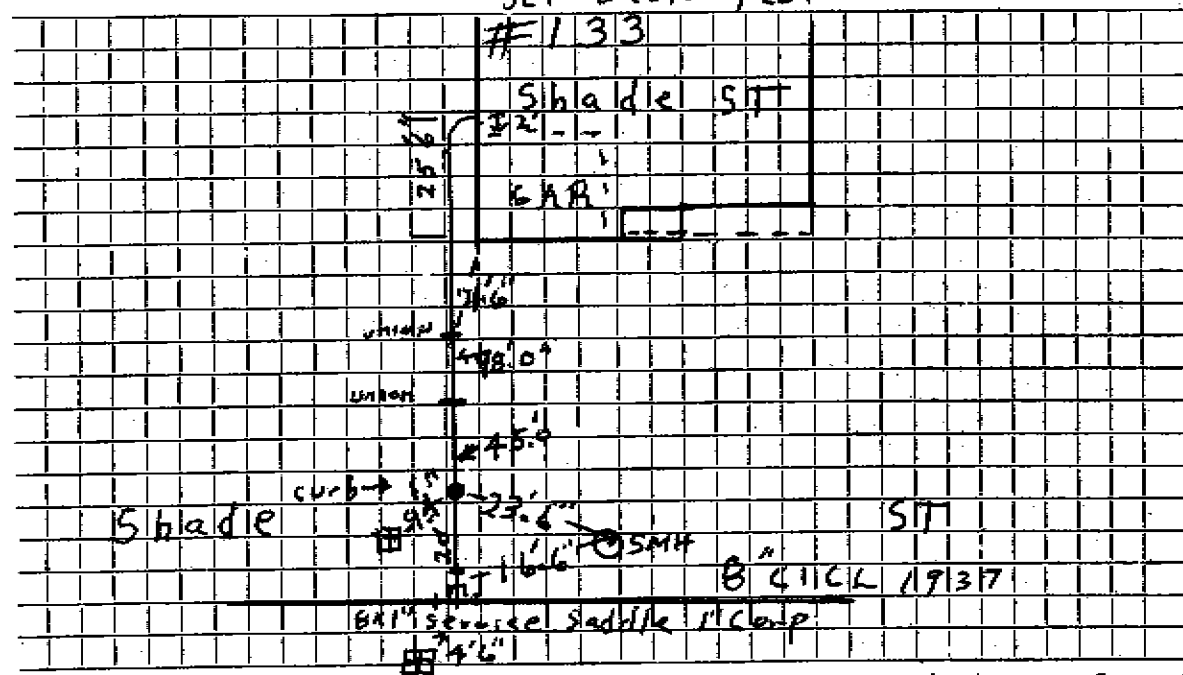

Connection made in Street.

Work completed 9/4/2008 J. McL.

Remarks: house SITS way back - that.....