

Name Minotti DiCicco

Service No. 293

Address 137 Shade Street

697

Lexington, Mass.

Locatio 137 Shade Street

7416

Kind of Pipe

Size

Size of Main

~~Work~~—New Service

Com. 11-6-50

Location

Date	Material	Amount	Total	Date	Amount
Sept. 20, '50	Labor	4 00	4 00	Sept 6 '50	7500
	10% Overhead		40		12
	70' - 3/4" Copper Tubing @.31		21 70		6622
	1 - 3/4" C x 1/2" I.W.H. S&W		3 76		No Charge
	1 - 3/4" C x 3/4" Union (3pts)		1 61	Sept. 20, '50	Labor
	Littlefield Shovel 3 hrs. @7.00	21 00		19' - 3/4" Copper Tubing @.31	5 89
	Trucking 1 hr. @.75		75	1 - 3/4" C Corp-cock	3 60
	Patching 13 x 3		13 00	1 - 3/4" C x 3/4" C Curb-cock	4 40
			66 22	1 - Box & Rod	3 35
				1 - 1/2" Offset Tail Piece	42
				1 - 1/2" Straight Tail Piece	42
				Littlefield Shovel 1 1/2 hrs. @7.00	10 50
				Trucking 1 hr. @.75	75
	Labor				33 76

DATE _____

TOWN OF LEXINGTON—BOARD OF PUBLIC WORKS

WATER DIVISION

The undersigned applies for a supply of water at No. _____ St. and hereby agrees to comply with the rules and regulations as now, or at any future time, established by the Board of Selectmen.


Am't. of Estimate \$ _____

Owner _____

Am't. Paid \$ _____

Address _____

Builder _____

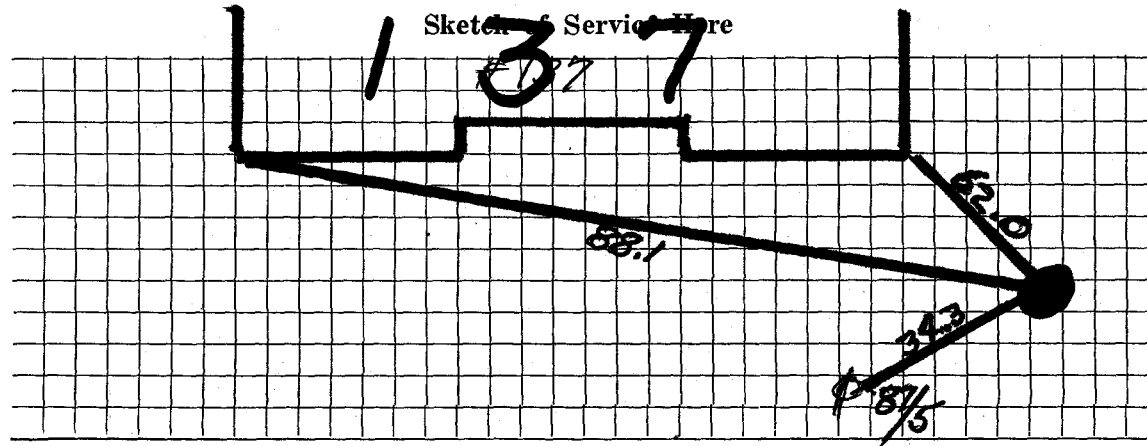

Connection made in _____ Street.

Work completed _____ 19

Remarks: