


DATE _____

TOWN OF LEXINGTON — BOARD OF PUBLIC WORKS
WATER DIVISION

Sketch of Service Here

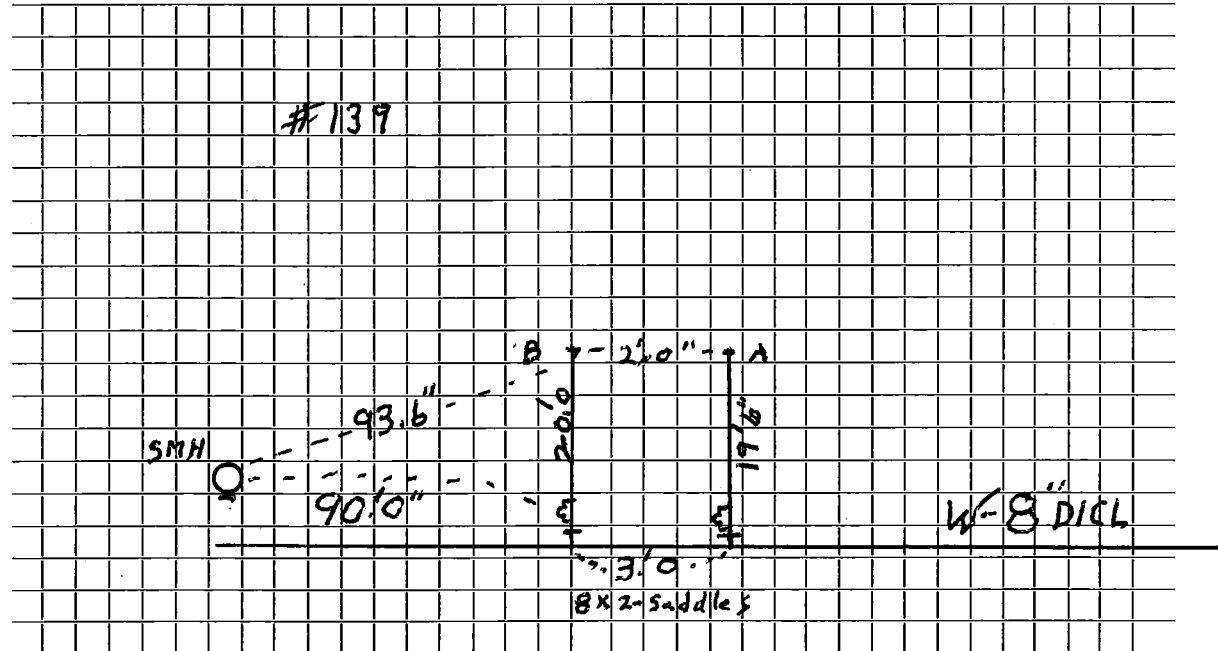

Connection made in Shade ST Street. Work completed 5/20/11 J. McLaughlin

Remarks: 2-2" service for Lots Rear of #139