




DATE 3/16/16

TOWN OF LEXINGTON — BOARD OF PUBLIC WORKS

WATER DIVISION

Sketch of Service Here

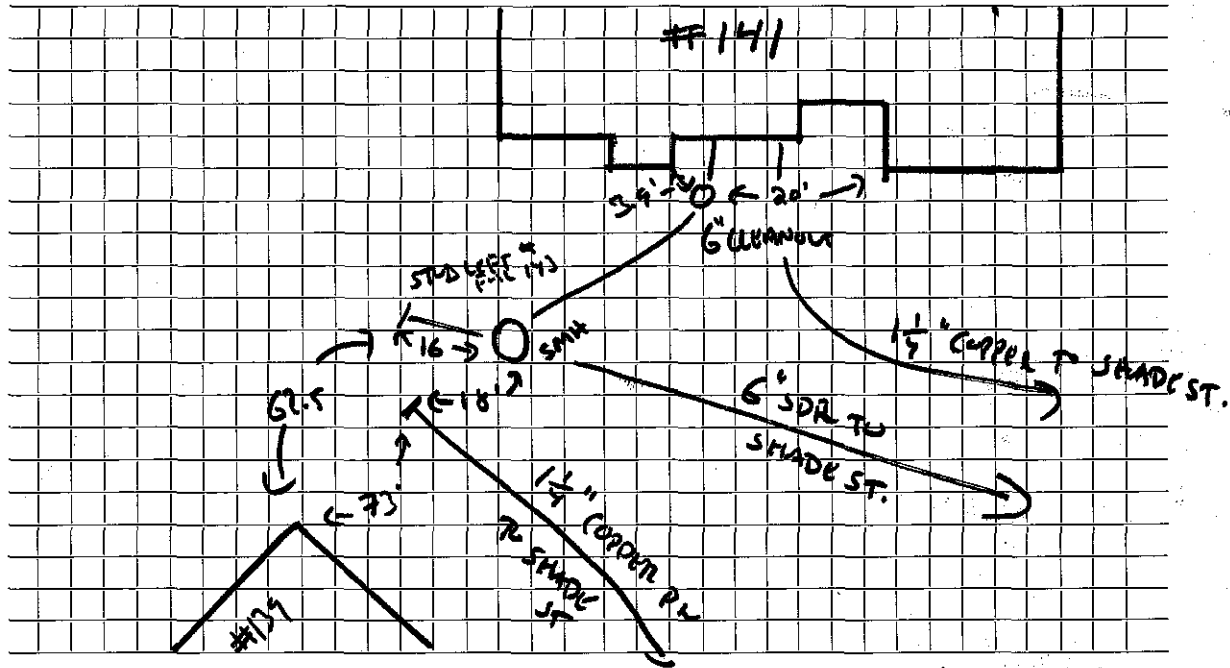

Connection made in ..... Street. Work completed ..... 10VINU

Remarks: .....  
.....  
.....