

WATER SERVICE RECORD

Name

Service No.

Address 143 SHADG ST

IRVING

Location

Repair—Renewal—New Service


Date	Material	Amount	Total	Date	Amount
9/20/7	<del>1/2" TYPE K COPPER</del>				
	<del>1" COPPER STOP</del>				
	<del>2" BRASS COP. R</del>				
	1" UNION, DRAB (2)				
	<del>1" TYPE K COPPER</del>				
	1" TYPE K COPPER				

CONNECTED  
 TO 3/24 CURD  
 LEFT  
 2011  
 BEHIND #147

DATE 9/2017

TOWN OF LEXINGTON — BOARD OF PUBLIC WORKS  
WATER DIVISION

Sketch of Service Here

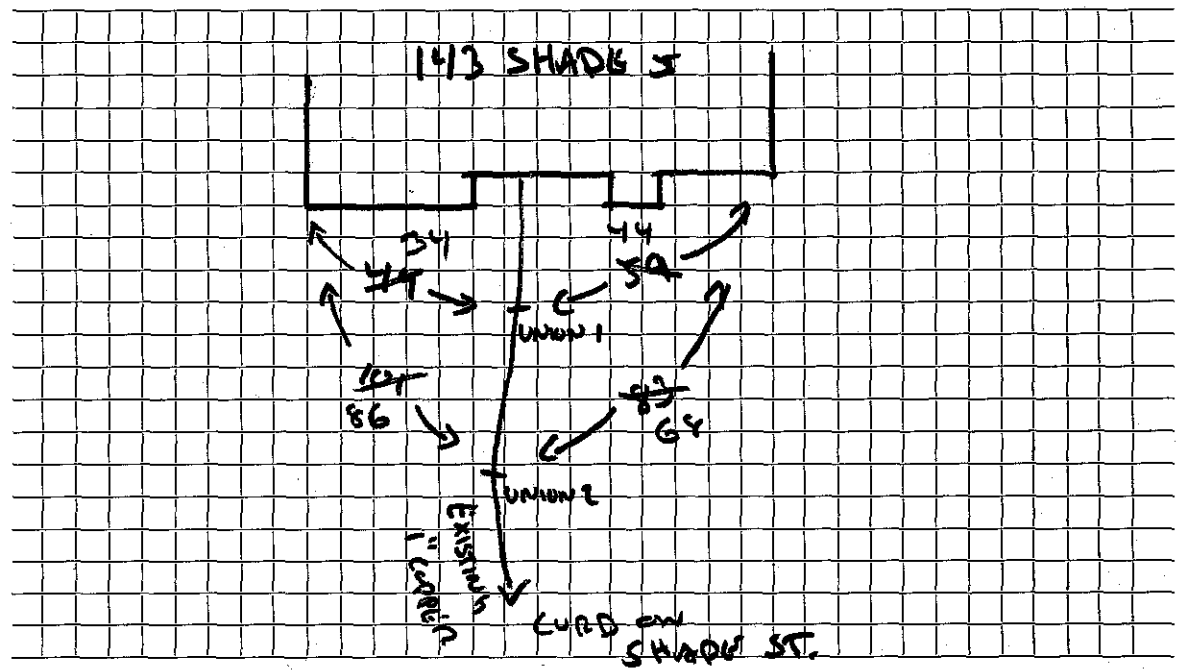

Connection made in ..... Street. Work completed ..... 10' INO ETC.

Remarks: ... CONNECTED TO 2' CURB STOP LEFT ON SHADE ST IN 2011; SEE "SHADE ST LOT DEPEND 149"