


TOWN OF LEXINGTON — BOARD OF PUBLIC WORKS
WATER DIVISION

Sketch of Service Here

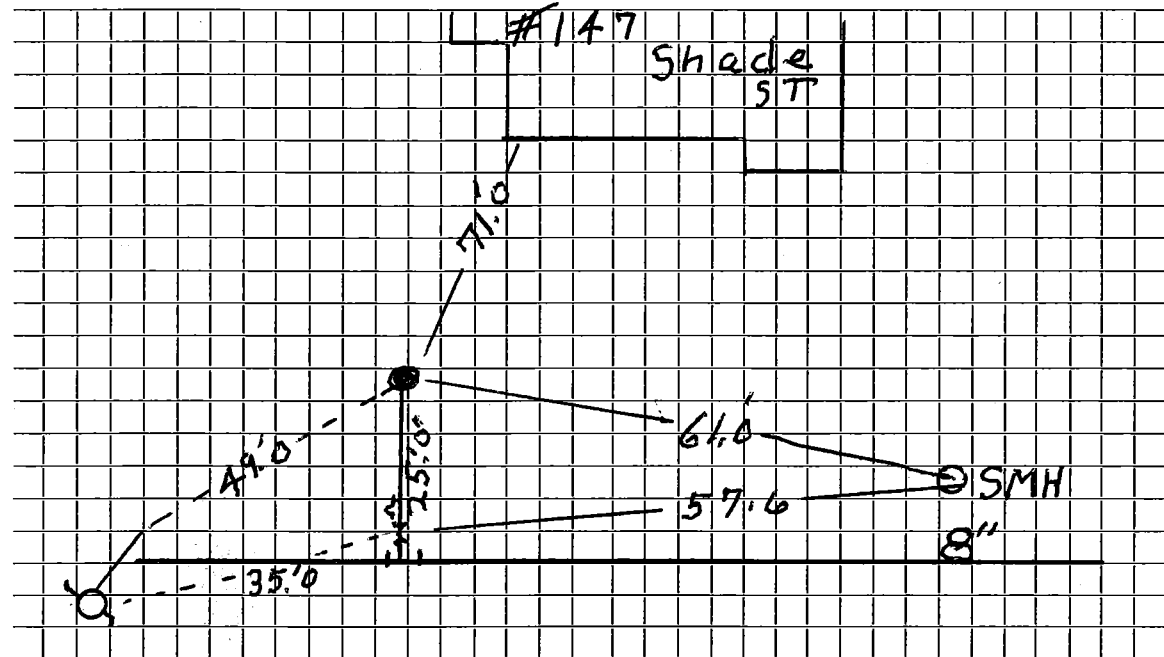

Connection made in _____ Street.

Work completed 5/20/2011 J. McLaughlin

Remarks: 8" x 2" Saddle w/ 2" Cor. P. / 2" Cor. b. / 2" Copper / (For house to be built behind 147)