

Name B. L. Bucit/

Service No.

# 4346  
# 2440

Address 36 Fountain Road, Arlington

147 Shade St. Location

147 Shade Street, Lexington, Mass.

Kind of Pipe

Size

Size of Main

~~Repair-Remove~~—New Service

Location

Date  
1939

Material

Amount

Total

Date

Amount

Apr. 25

2 hrs. @ 60¢

1 20

April 24, 1939 Deposited

49 00

88' 3/4" Copper Tubing @ 20¢

7 60

1 3/4" S. & W.

3 75

1 3/4" C. Union (3 part)

1 10

Trucking, 2 hrs. @ 75¢

1 50

Trench Repairs

5 10

20 25

Flat Rate:

88' @ 50¢

\$44.00

Trench Repairs

5 00

\$49 00

Labor

Hadley Press, Inc., Lexington

Sum v-1839

(C. Tracy 5.10?)

70' @ 50¢ 35' @ 50¢  
Catching 14  
49.00

DATE Sept 15, 1938

TOWN OF LEXINGTON—BOARD OF PUBLIC WORKS

WATER DIVISION

Lots 201 & 2  
Bureau of  
Records

The undersigned applies for a supply of water at No. 147 Shad St. and hereby agrees to comply with the rules and regulations as now, or at any future time, established by the Board of Selectmen.

Am't. of Estimate \$ 49.00 Inc. Catch.

Owner B. L. Bueit


Am't. Paid \$ \_\_\_\_\_

Address 36 Mountain Rd.

Builder \_\_\_\_\_

Lexington

Sketch of Service Here

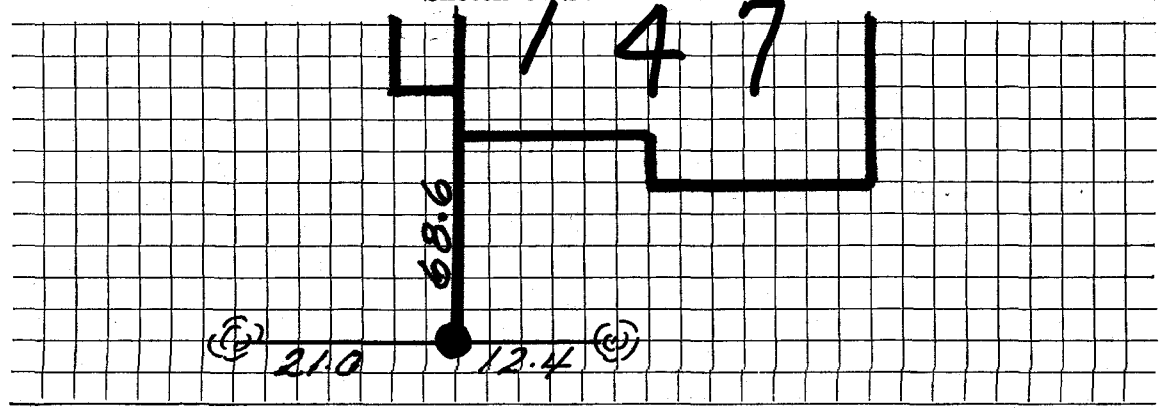

Connection made in \_\_\_\_\_ Street.

Work completed \_\_\_\_\_ 19

Remarks: