

Name Emilio A. Graziano

1130

Service No. ~~2-1939~~ #4349 2441

Address 28 Willow Avenue, Somerville,

151 Shade St.

Location 151 Shade Street Lots 200A and 200B.

Kind of Pipe

Size

Size of Main

Repair-Renewal—New Service

Location

Date

Material

Amount

Total

Date

Amount

March 27.

1939

2 hrs. @ 60¢

1 20

March 10, 1939 Deposited

43 00

from 5-14-39

76' 3/4" Cop. Tubing @ 20¢

15 20

1 3/4" S. & W.

3 75

Trucking, 2 hrs. @ 75¢

1 50

Trench Repairs

5 10

26 75

Flat Rate:

76' @ 50¢

\$38.00

Trench Repairs

5.00

\$43.00

Labor

DATE Mar 8. 1939

TOWN OF LEXINGTON—BOARD OF PUBLIC WORKS

WATER DIVISION Lot 2004 & 200 B.

The undersigned applies for a supply of water at No. 151 Shade St. St. and hereby agrees to comply with the rules and regulations as now, or at any future time, established by the Board of Selectmen.

Am't. of Estimate \$ 43⁰⁰ Inc. Patch.

Owner Emilio A. Graziano


Am't. Paid \$ _____

Address 28 Melaw Ave

Builder _____

Somerville

Sketch of Service Here

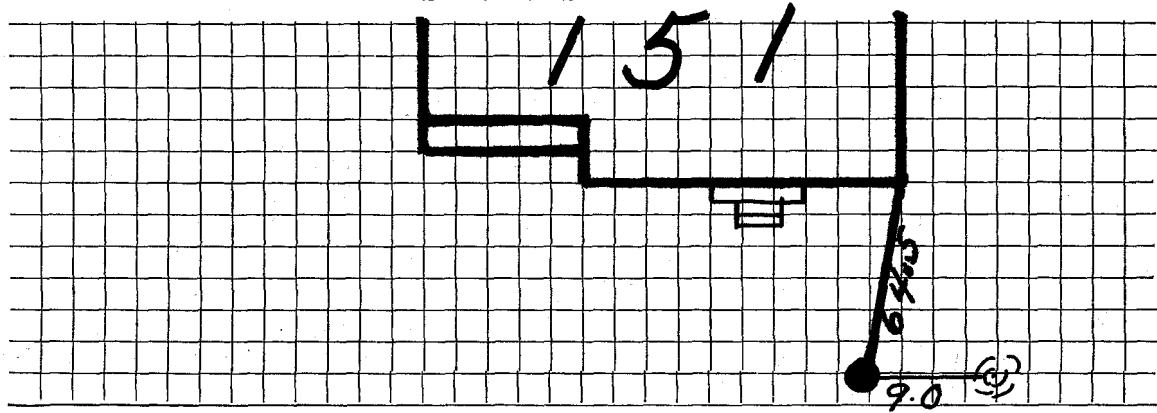

Connection made in _____ Street.

Work completed _____ 19

Remarks: