

Name Arthur Lanquist

Service No.

Address 153 Shade Street

Lexington, Mass.

Location 153 Shade Street

136
#5408
#3409

Kind of Pipe

Size

Size of Main

~~Repair - Renewal~~ - New Service

Location

Date	Material	Amount	Total	Date	Amount
Aug. 20 '48	Labor	7 55	7 55	Aug 19 '48	80 00
	10% Overhead		76		1360
	74'-3/4" Copper Tubing		18 87		66 40
	1-3/4" C x 1/2" I.W.H. S & W		3 15	Aug. 21, '48 Labor	4 72
	1-3/4" C x 3/4" C. Union (3 Pts)		1 32	21'-3/4" Copper Tubing	5 36
	3 hrs. Littlefield Shovel		21 00	1-3/4" C. Corp. Cock	3 00
	1 hr. Trucking		75	1-3/4" C x 3/4" C. Corp Cock	3 68
	Patching 13 x 3		13 00	1-Box & Rod	3 55
			66 40	2 1/2 hrs. Littlefield Shovel	17 50
				1-1/2" Offset Tail Piece	30
				1-1/2" Straight Tail Piece	30
				1 hr. Trucking	75
	Labor				39 16

Com. 10/25/48

Deposited
Refunded
Non Charge

TOWN OF LEXINGTON—BOARD OF PUBLIC WORKS

WATER DIVISION

The undersigned applies for a supply of water at No. _____ St. and hereby agrees to comply with the rules and regulations as now, or at any future time, established by the Board of Selectmen.

Am't. of Estimate \$ _____


Owner _____

Am't. Paid \$ _____

Address _____

Builder _____

Sketch of Service Here

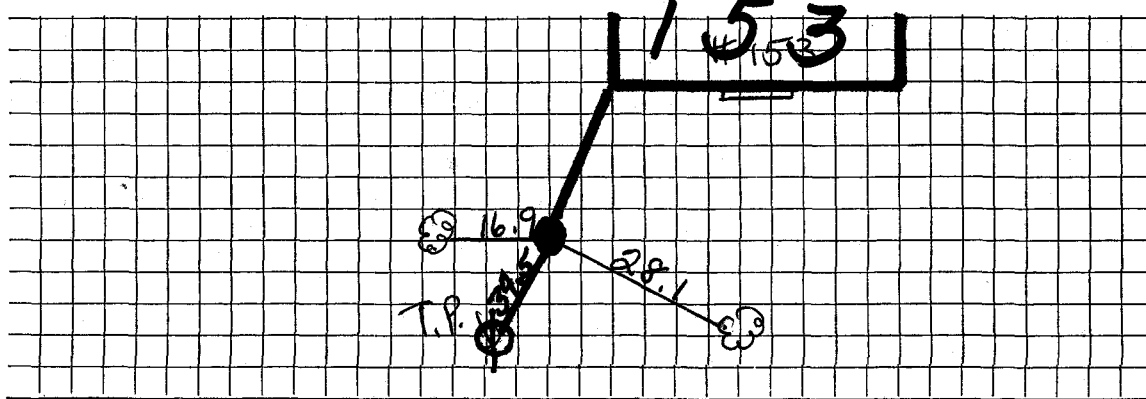

Connection made in _____ Street.

Work completed _____ 19

Remarks: