


DATE 8-6-1999

TOWN OF LEXINGTON — BOARD OF PUBLIC WORKS
WATER DIVISION

Sketch of Service Here

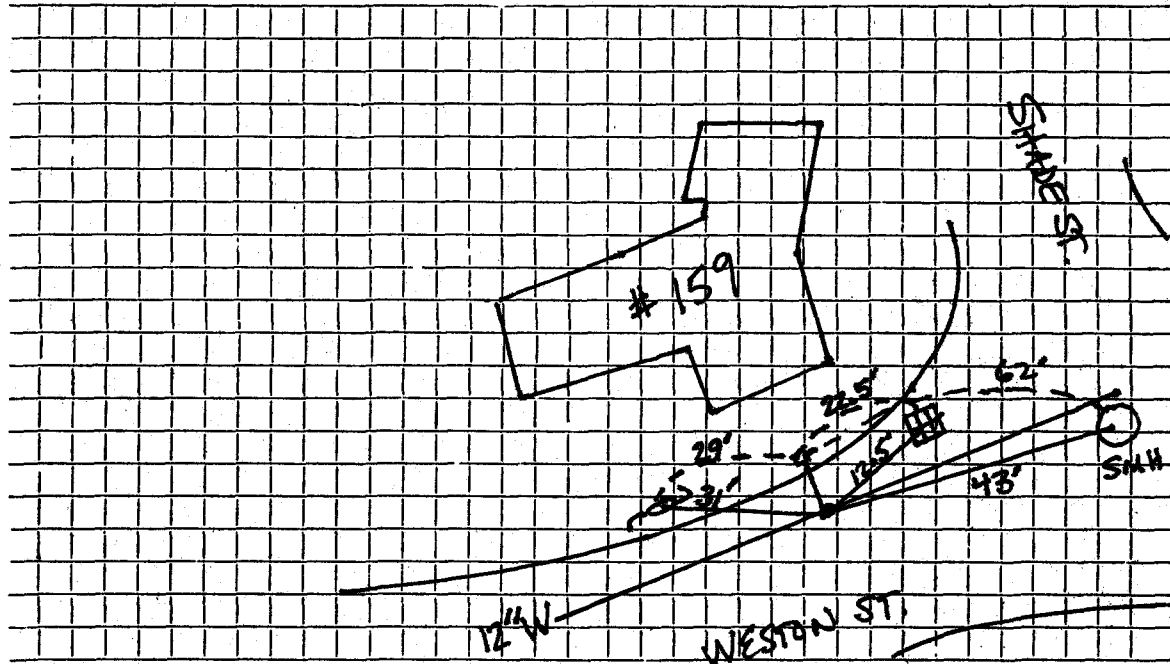

Connection made in 12" W. MAIN ON WESTON ST. ... Street.

Work completed NEW CORPORATION, UNICOR

Remarks:

.....


.....

DATE _____

TOWN OF LEXINGTON — BOARD OF PUBLIC WORKS

WATER DIVISION

Sketch of Service Here

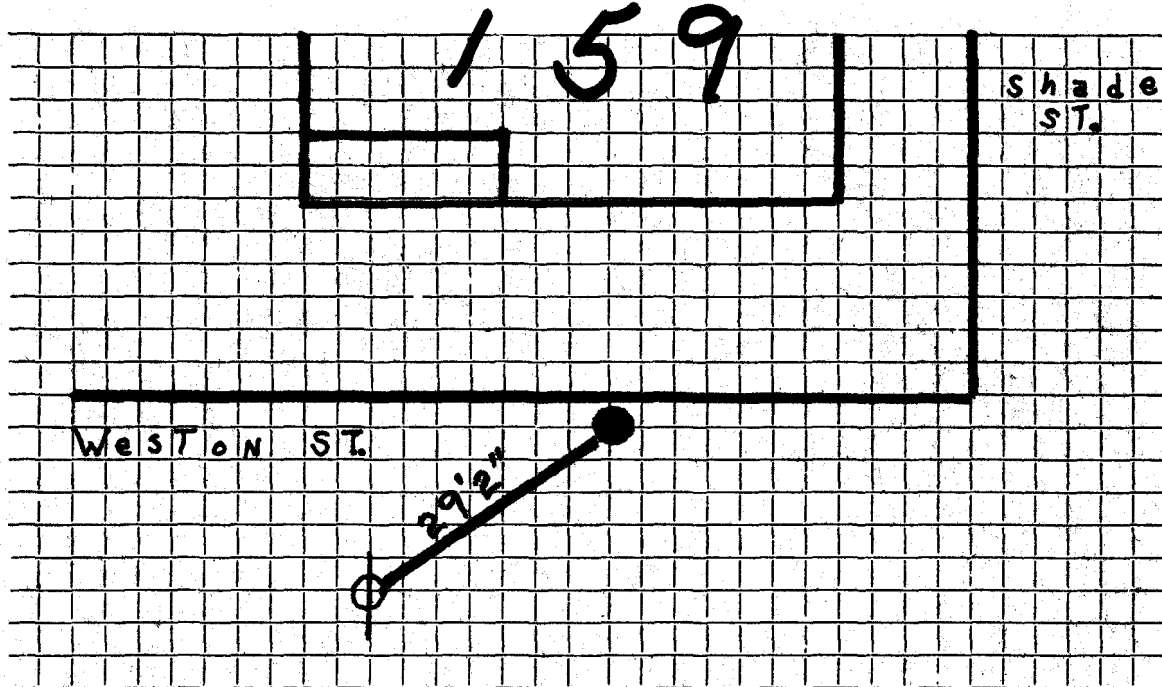

Connection made in Street. Work completed

Remarks:

.....

.....