


DATE _____

TOWN OF LEXINGTON — BOARD OF PUBLIC WORKS

WATER DIVISION

Sketch of Service Here

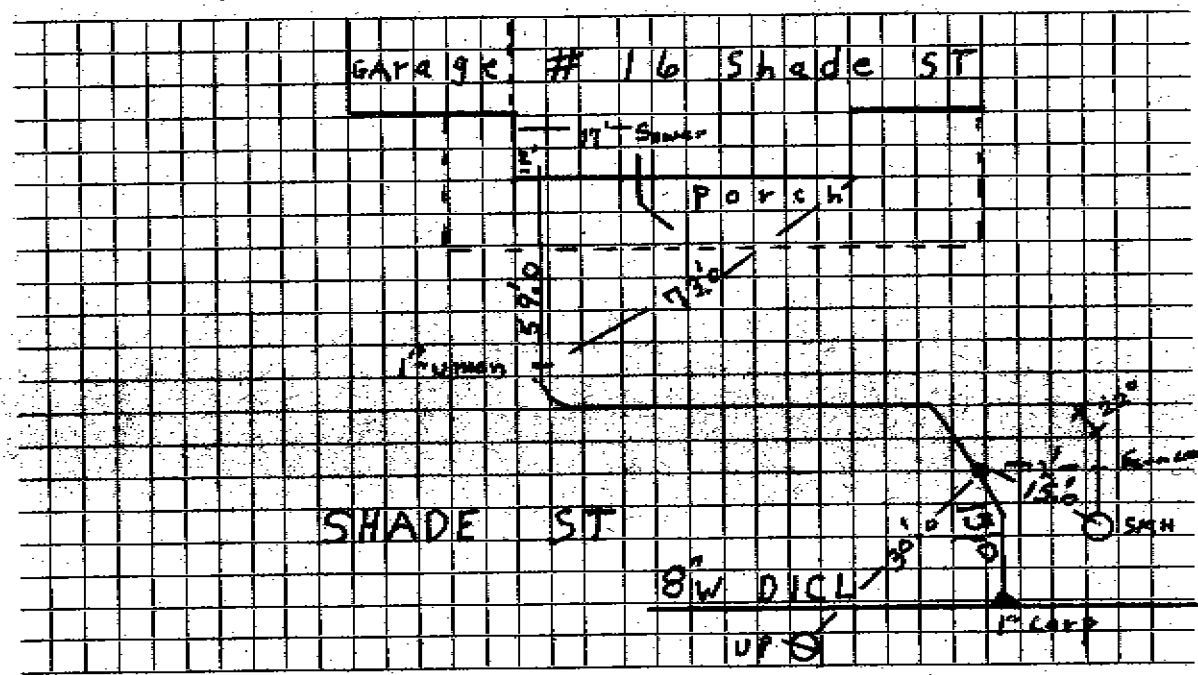

18

Connection made in Street. Work completed 12/11/07. NO. In sp. NO. Permit.

Remarks: WATER MAIN 8" DI. 2005.06. Cadron +
NO-16 and 18 cu-b are beside each other