

Name Henry Moulton

Service No.

3336

Address 17 Shade Street

1937

Lexington, Mass.

Location 17 Shade Street

Kind of Pipe

Size

Size of Main

~~REPAIR-RENEWAL~~—New Service

Location

Date	Material	Amount	Total	Date	Amount
Aug. 6, '47	Labor	9 95		Aug 4 '47	50 00
9	"	13 30		Oct 15 '47	16 85
11	"	9 70	32 95		66 85
	10% Overhead		3 30	Aug. 8-8-	
	40' - 3/4" Copper Tubing @.28		11 20	9-11, '47 Labor	39 25
	1 - 3/4" C x 1/8" I.W.H. S & W		3 15	10' - 3/4" Copper Tubing @.28	2 80
	Shovel-Trailer-Tractor		6 00	1 - 3/4" C Corp-cock	3 00
	Compressor 2 hrs. @1.75		3 50	1 - 3/4" C x 3/4" C Curb-cock	3 68
	Patching 6 x 3		6 00	1 - Box & Rod	4 26
	Trucking 1 hr. @.75		75	Dynamite 3 lbs. @.21	63
			66 85	Exploders 5 @.105	53
	<i>Bill and 2-16-47</i>			1' - 1/2" Offset & Straight Tail Piece	60
	Labor			Compressor 2 hrs. @1.75	3 50
				Shovel - Trailer - Tractor	1 50
				Trucking 1 hr. @.75	75
					60 50

TOWN OF LEXINGTON - BOARD OF PUBLIC WORKS

WATER DIVISION

The undersigned applies for a supply of water at No..... St. and hereby agrees to comply with the rules and regulations as now, or at any future time, established by the Board of Selectmen.

Am't of Estimate \$.....

Owner


Am't Paid \$.....

Address

Builder

.....

Sketch of Service Here

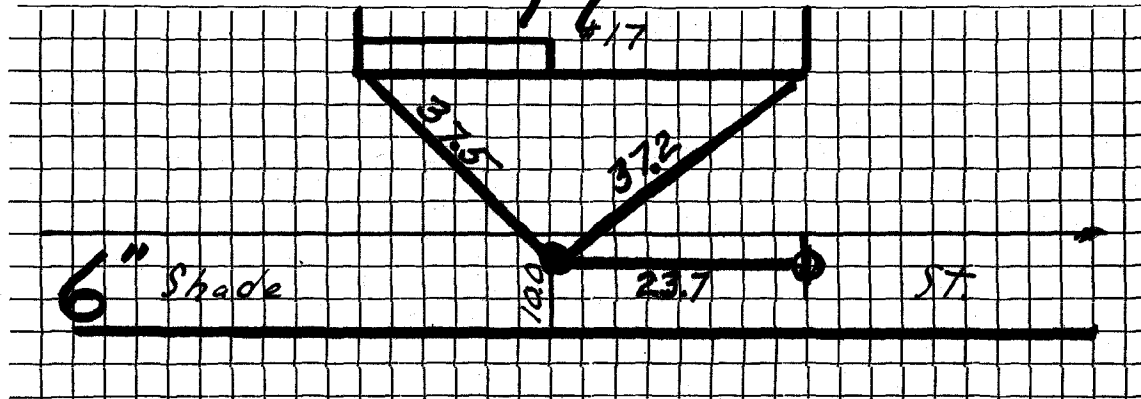

Connection made in Street.

Work completed19

Remarks: