




DATE \_\_\_\_\_

TOWN OF LEXINGTON — BOARD OF PUBLIC WORKS

WATER DIVISION

Sketch of Service Here

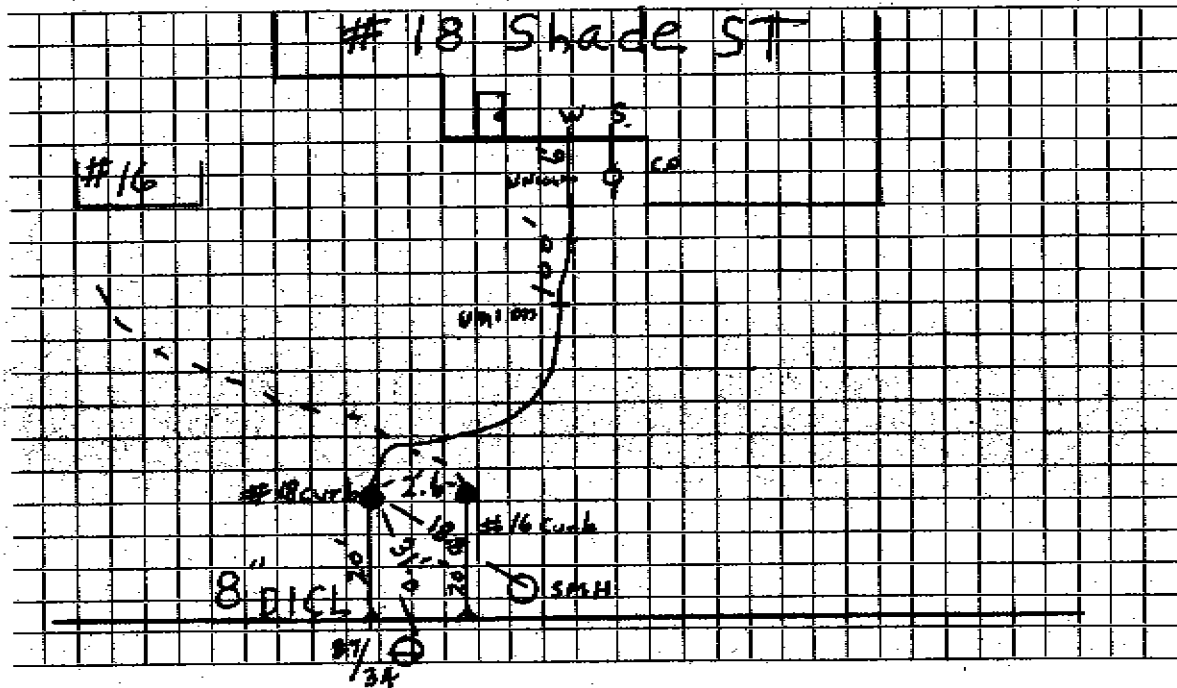

Connection made in ..... Street. Work completed .....

Remarks: Larry Carroll Jr. INST. from existing 1st Contractor To house/water & Sewer  
Water is higher than sewer  
contour land services