

Name Henry Moulton

Service No.

82  
3335

Address 21 shade Street

# 385

Lexington, Mass.

Location 21 Shade Street

# 386

Kind of Pipe

Size

Size of Main

~~REPAIR-RENEWAL~~ New Service

Location

Date	Material	Amount	Total	Date	Amount
Aug. 6, '47	Labor	11 85		Aug 4 '47	50 00
8	"	10 48		Oct 15 '47	38 01
11	"	18 56	40 89		88 01
	10% Overhead		4 09		
	55' - 3/4" Copper Tubing @.28	15 40		Aug. 6, '47 -	
	1 - 3/4" C x 1/8" I.W.H. S & W	3 15		8 - 11 Labor	44 09
	Dynamite 30 lbs. @ .21	6 30		8' - 3/4" Copper Tubing @.28	2 24
	Exploders 16 @ .105	1 68		1 - 3/4" C Corp-cock	3 00
	Compressor 2 hrs. @1.75	3 50		1 - 3/4" C x 3/4" C Curb-cock	3 68
	Shovel - Trailer - Tractor	8 25		1 - Box & Rod	4 26
	Patching 4 x 3	4 00		Dynamite 10 lbs. @.21	2 10
	Trucking 1 hr. @.75	75		Exploders 12 @ .105	1 26
	Labor	88 01		1 - 1/2" Offset & Straight Tail Piece	60
	<i>Bill sent 9-16-47</i>			Compressor 5 hrs. @1.75	8 75
				Shovel - Trailer - Tractor	1 20
				Trucking 1 hr. @.75	75
					<u>71 93</u>

TOWN OF LEXINGTON - BOARD OF PUBLIC WORKS

**WATER DIVISION**

The undersigned applies for a supply of water at No..... St. and hereby agrees to comply with the rules and regulations as now, or at any future time, established by the Board of Selectmen.

Am't of Estimate \$.....

Owner ..... *1416 Mass Avenue* .....


Am't Paid \$.....

Address ..... *Harvard Square* .....

Builder .....

..... *Cambridge, Mass.* .....

Sketch of Service Here

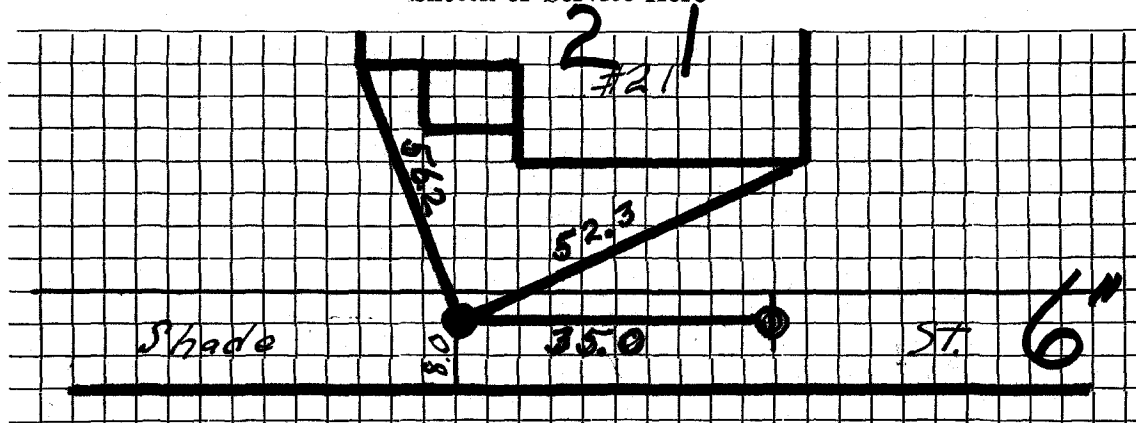

Connection made in ..... Street.

Work completed .....19

Remarks: