

WATER SERVICE RECORD

Name William Gorman

Service No. 18

Address 25 Shade Street

Location

~~Renewal~~—Renewal—~~NEW SERVICE~~ W.O. 5584

DEC 12 1977

Date		Material	Amount	Total	Date	Amount
7/22/77		Labor	118 80		7-8-77	325 00
8/2/77			45 36		11-13-77	17 30
8/3/77			39 60			357 70
			203 76			
		10% O.H.	20 37	224 13		
	58'	3/4 Copper @ .83	43 14	48 14		
	1	3/4 Wheelhandle		15 98		
	2	3/4x1/2 Bushings @ 1.46		2 92		
	6	Yds. Gravel @ 2.18		13 08		
	3	Yds. Loam @ 4.50		13 50		
	5	Lbs. Seed @ .39		1 95		
	1/2	Bag Lime		1 00		
	1/2	Bag Fert.		1 00		
	5 1/2	Hrs. Trucking @ 3.00		16 50		
	3	Hrs Shovel @ 6.50		19 50		
				357 70		


3/4" Copper

DATE _____

TOWN OF LEXINGTON — BOARD OF PUBLIC WORKS

WATER DIVISION

Sketch of Service Here

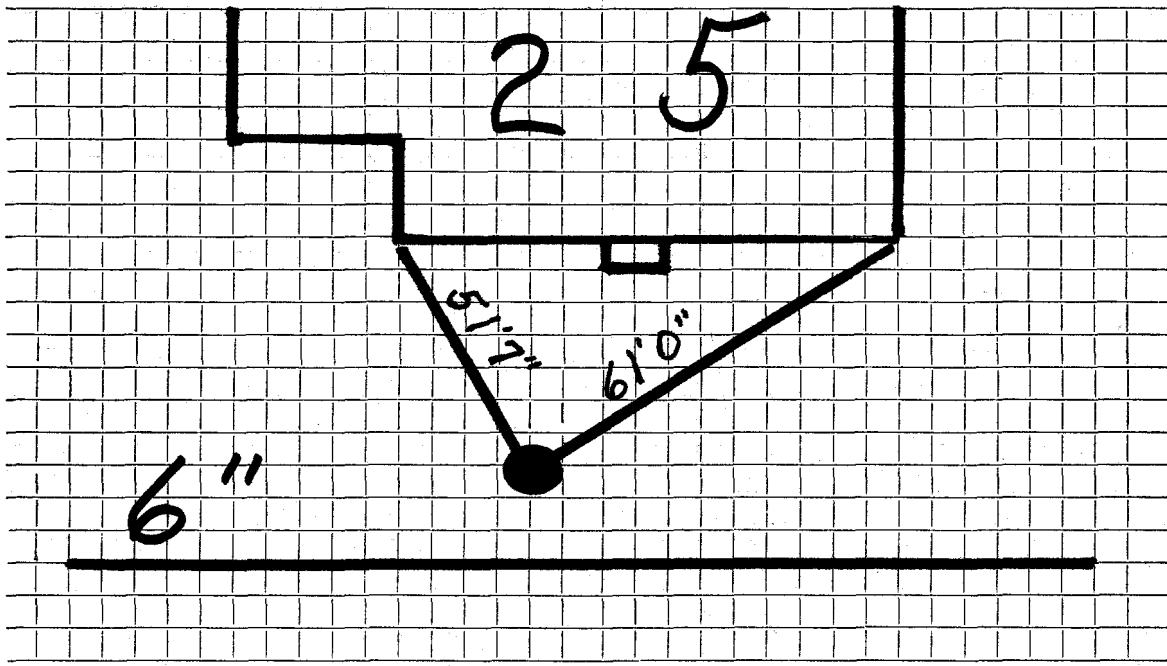

Connection made in Street. Work completed

Remarks: *Original Service 11-2-35*.....
.....
.....