

WATER SERVICE RECORD

Name Joseph Chisholm

Service No. #68

Address 28 Shade Street

6859

Location Lot #13

Repair—Renewal—New Service WO #7343

Comm 10-1-62


Date	Material	Amount	Total	Date	Amount
6-12-62	Labor	2.24		6-5-62	Deposited 50.00
	10% O.H.	.22	2.46	6-5-62	★ Renewal 12.69
54.0	3/4" Copper tubing @ .42		22.68		
1	3/4" CX 1/2 I.W.H. Stop & Waste		6.17		
			31.31		Non Charge
				6-21-62	Labor 1.86
				27	3/4" Copper Tubing @ .82 22.14
				1	3/4" C Corp Cock 4.91
				1	3/4" C Curb Cock 6.28
				1	Box & Rod 4.90
				1	1/2 Straight Tailpiece .50
				1	1/2 Offset Tailpiece .50
					47.09
					★ Applied to street 7/

DATE _____

TOWN OF LEXINGTON — BOARD OF PUBLIC WORKS

WATER DIVISION

Sketch of Service Here

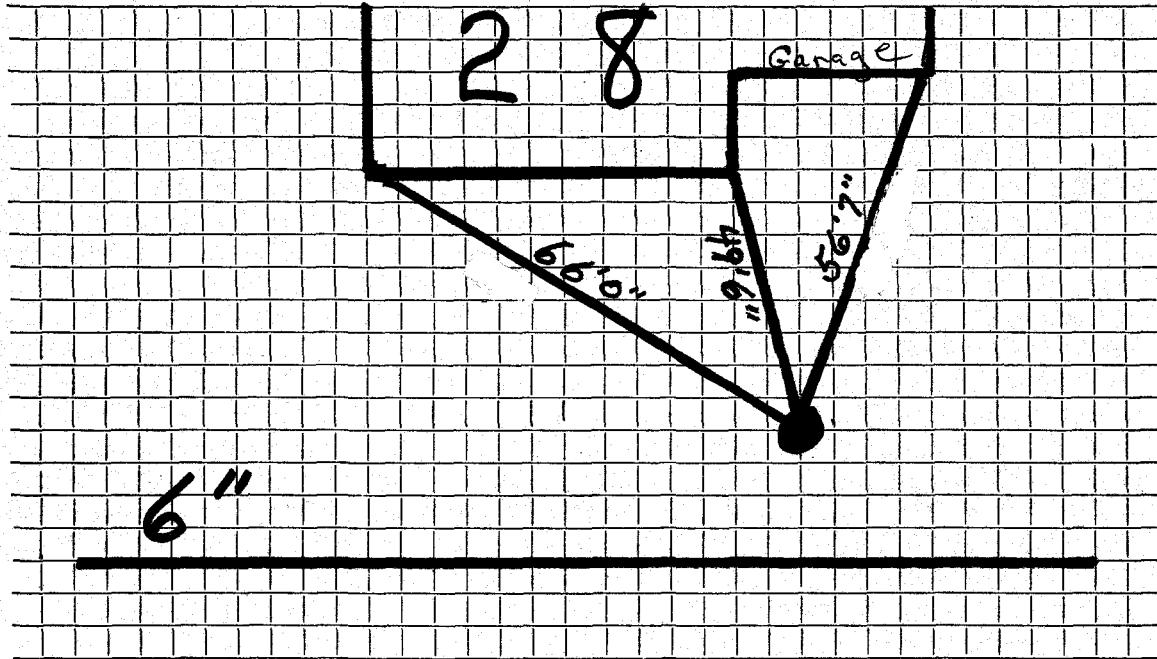

Connection made in Street. Work completed

Remarks:

.....

.....