


DATE _____

TOWN OF LEXINGTON — BOARD OF PUBLIC WORKS

WATER DIVISION

Sketch of Service Here

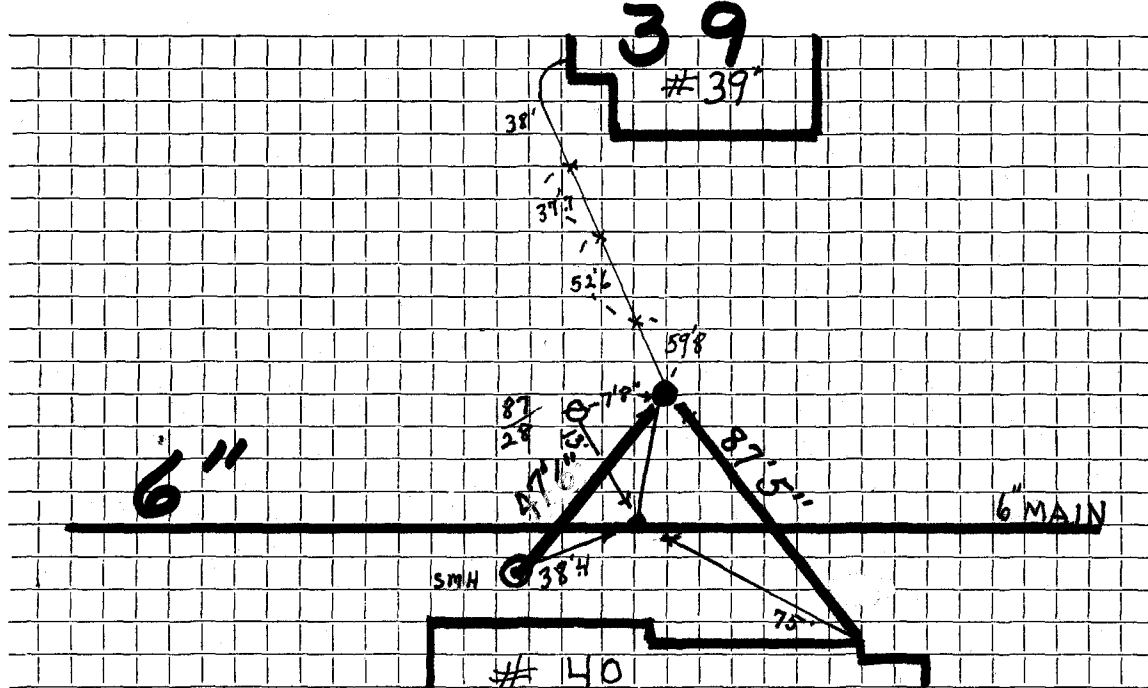

Connection made in SHADE ST Street. Work completed

Remarks: Corporation 4' 3" Deep