

Name Arnold Westrum

Service No. 30 3/22 ✓

Address 54 Shade Street

Lexington, Mass.

Location 54 Shade Street

Kind of Pipe

Size

Size of Main

~~Repair~~ - ~~Renewal~~ - New Service

Com 9-16-46

Location

Date	Material	Amount	Total	Date	Amount
May 16, '46	Labor	90	90	May 13, '46	25 00
	10% Overhead	09	09	Mar 24 '47	3 45
	49' - 3/4" Copper Tubing @ .1815	8 89			Non-Charge
	1 - 3/4" C x 1/2" I.W.H. Stop & Waste	2 82		May 10, '46	Labor 23 10
	Trucking 1 hr. @ .75		75		22' - 3/4" Copper Tubing @ .1815 3 99
	Patching 15 x 3		15 00		1 - 3/4" C. Corp-cock 2 70
			28 45		1 - 3/4" c x 3/4" C. Curb-cock 3 30
Mar 24 '47	Altered		3 46		1 - Box & Rod 1 65
			25 00		1 - 1/2" Straight Tail Piece 90
	<u>Trench Dug By Owner</u>				1 - 1/2" Offset Tail Piece 90
					trucking 1 hr. @ .75 75
					<u>37.29</u>
	Labor				

Hadley Press, Inc., Lexington

DATE _____

TOWN OF LEXINGTON—BOARD OF PUBLIC WORKS

WATER DIVISION

The undersigned applies for a supply of water at No. _____ St. and hereby agrees to comply with the rules and regulations as now, or at any future time, established by the Board of Selectmen.


Am't. of Estimate \$ _____

Owner _____

Am't. Paid \$ _____

Address _____

Builder _____

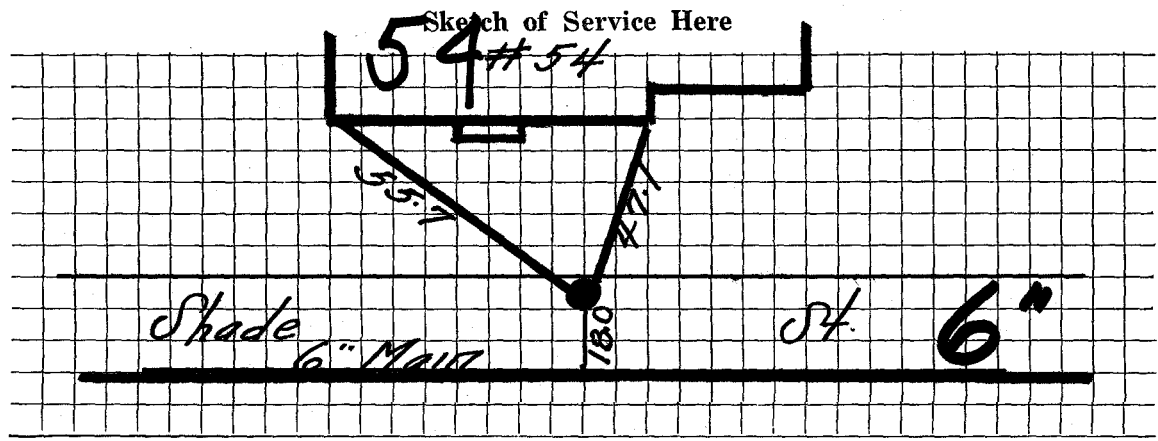

Connection made in _____ Street..

Work completed _____ 19

Remarks: