

WATER SERVICE RECORD

Name

Service No.

Address

Location 56 Shade Street

Repair—Renewal—New Service


Date	Material	Amount	Total	Date	Amount
11-14-51	60' 3/4" Copper				
	1 3/4" C. X 1/2" I.W.H.			11-13-51	
	Stop + Waste				
					25' 3/4" Copper
					1 3/4" C. Corp Cock
					1 3/4" C. X 3/4" C. Curb Cock
					1 Box + Rod
				12-13-61	Repair
					1' 3/4" Copper
					1 3/4" Curb Cock
					1 3/4" Style 88 Coupling
					1 3/4" - 3 Part Union

DATE _____

TOWN OF LEXINGTON — BOARD OF PUBLIC WORKS

WATER DIVISION

Sketch of Service Here

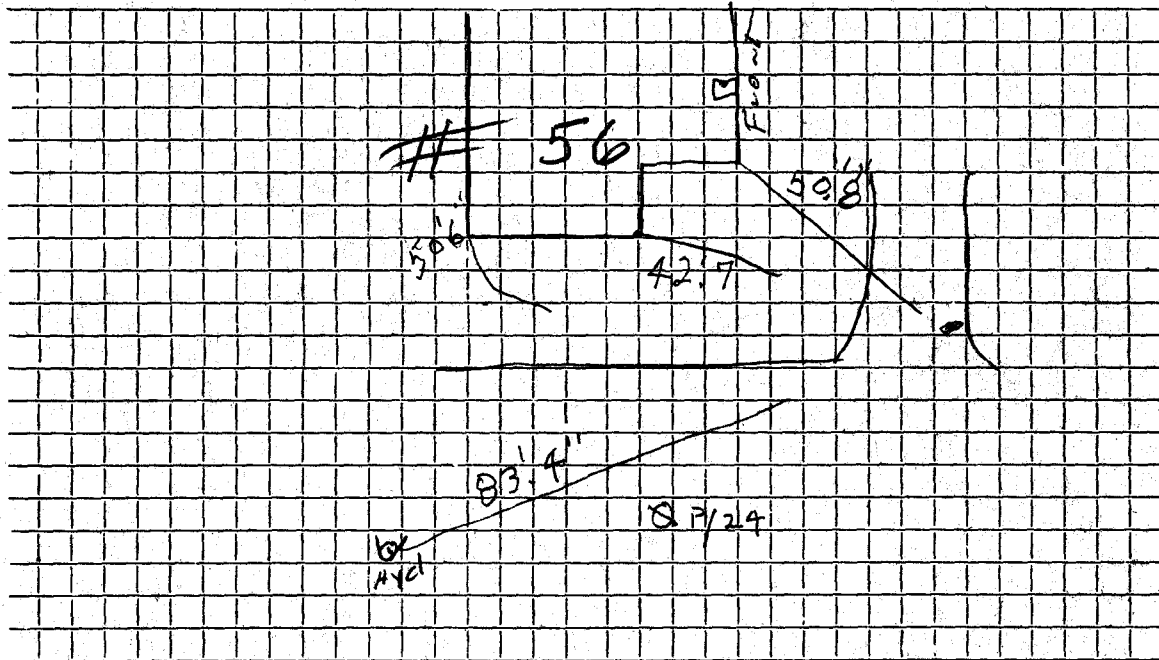

Connection made in Street. Work completed

Remarks:
.....
.....