

Name R. B. Burrows

Service No. 10 2429

Address 20 Lapham Street, Medford,  
61 Shade St.

Location 61 Shade Street

Kind of Pipe

Size

Size of Main

Repair—Renewal—New Service

Location

Date

Material

Amount

Total

Date

Amount

May 1, 1940

4 hrs. @ 60¢

2 40

April 29, 1940

Deposited

24.00

Com 6/1/40

10% Overhead

24

2 64

48' 3/4" Coppertubing @ 18¢

8 64

1 3/4" C x 1/2" I S. & W.

2 25

1 hr. trucking @ 75¢

75

Trench repairs

10 00

24 28

Say \$24.00

10/03 110' - 2" copper  
1 - 3/4 x 1 union

Labor

Hidley Press, Inc., Lexington

DATE Mar. 8, 1940

TOWN OF LEXINGTON—BOARD OF PUBLIC WORKS  
WATER DIVISION

The undersigned applies for a supply of water at No. 61 Shade St. St. and hereby agrees to comply with the rules and regulations as now, or at any future time, established by the Board of Selectmen.

Am't. of Estimate \$ 24<sup>00</sup>


Owner A. C. and R. B. Burrows

Am't. Paid \$ \_\_\_\_\_

Address 20 Lakham St

Builder R. Burrows

Medford

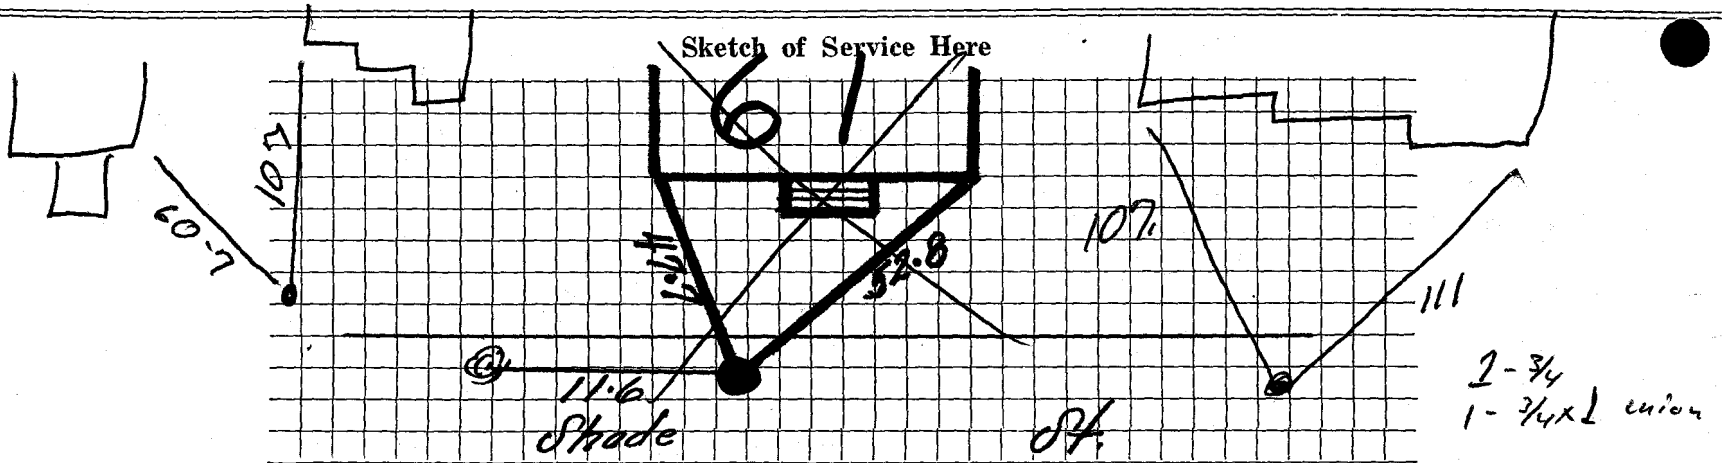

Connection made in \_\_\_\_\_ Street.

Work completed \_\_\_\_\_ 19

Remarks: