




DATE \_\_\_\_\_

TOWN OF LEXINGTON — BOARD OF PUBLIC WORKS

WATER DIVISION

Sketch of Service Here  
63

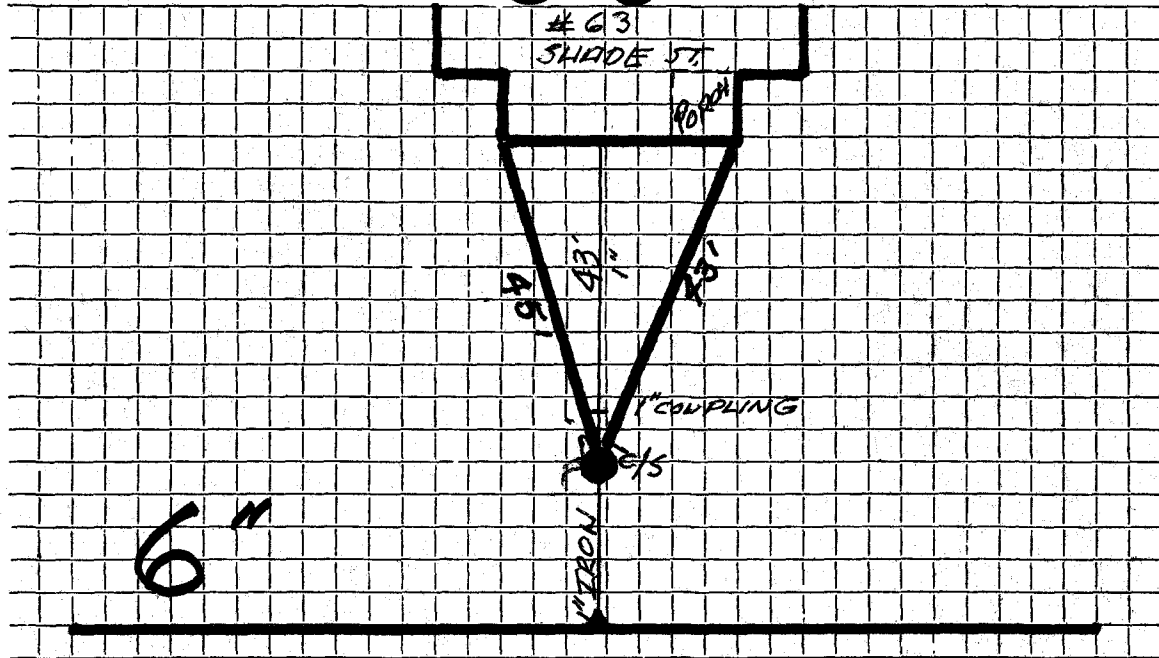

Connection made in SHADE Street. Work completed .....

Remarks: 1\" IRON IN STREET (LOW PRESSURE) Original 6-21-32