

WATER SERVICE RECORD

Name

Service No.

Address

Location 64 Shade Street

Repair—Renewal—New Service


Date	Material	Amount	Total	Date	Amount
1-3-'51	48' 3/4" Copper				
	1 3/4" C. X 1/2" I.W.H. Stop & Waste			1-3-'51	
					22' 3/4" Copper
					1 3/4" C. Corp Cock
					1 3/4" C. X 3/4" C. Curb Cock
					1 3/4" C. X 3/4" C. - 3 Part Union
					1 Box & Rod
				12-11-61	Repair
					3' 3/4" Copper
					1 3/4" C. Curb Cock
					1 3/4" Style 88 Coupling
					1 3/4" 3 Part Union

DATE _____

TOWN OF LEXINGTON — BOARD OF PUBLIC WORKS

WATER DIVISION

Sketch of Service Here

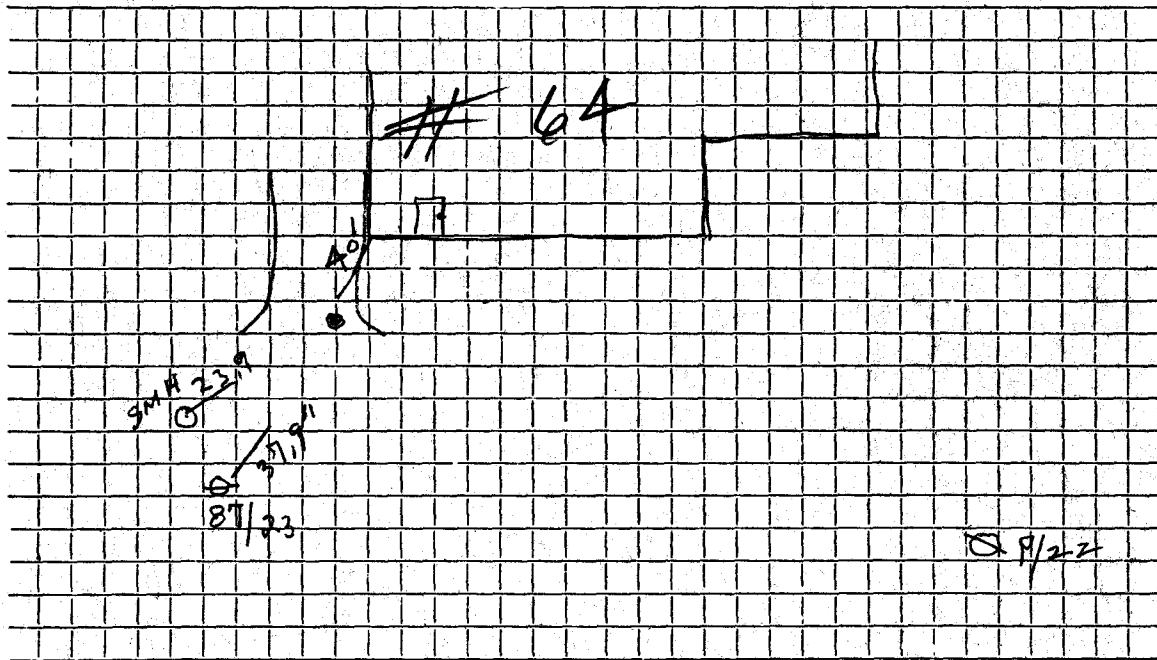

Connection made in Street. Work completed

Remarks:
.....
.....