


TOWN OF LEXINGTON — BOARD OF PUBLIC WORKS

WATER DIVISION

Sketch of Service Here

Now #1 Fairbanks 13A

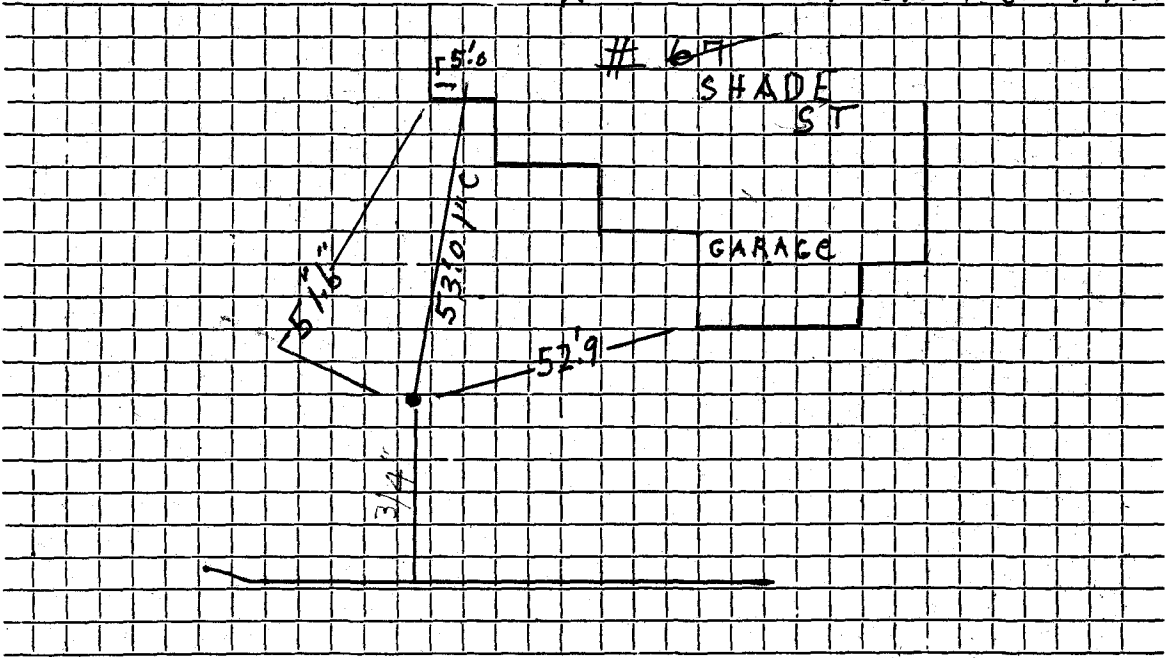

Connection made in Street.

Work completed 9/28/05 J. McLaughlin

Remarks: 2006 Installing 8" D.I.P. AND 1" Service's I.N.S.T.