

Name George F. Pearson

Service No.

2431

Address 81 Audubon Road, Boston

68 Shade St.

#68 Shade St.

Location

Lot 241, 242, Shade St.

Kind of Pipe

Size

Size of Main

~~Repair-Renewal~~ - New Service

Location

Date	Material	Amount	Total	Date	Amount
P.S. 7-29 for 26.01	38 1" C.L. Pipe @ .27	10 26			
	3 1" L.L. Ells @ .35	1 05			
	1 1" Br. Sp. Nipple	25			
	1 S & W	3 00			
	Trucking	75			
	Constr. Charge	3 00	18 31		
4/17/29	10 Hrs. Labor @ .55	5 50		April 2 1929 - Cash	17 50
	2 " " @ .60	1 20	6 70	Oct. 3 1929 - Cash	9 01
	15% Overhead		1 00		
			26 01		
	Labor				

Hadley Press, Inc., Lexington

Trench dig.

DATE April 2, 1929

TOWN OF LEXINGTON—BOARD OF PUBLIC WORKS

WATER DIVISION

The undersigned applies for a supply of water at No. <sup>Lot</sup> 241, 242 - Shade St. and hereby agrees to comply with the rules and regulations as now, or at any future time, established by the Board of Selectmen.

Am't. of Estimate \$ 17<sup>00</sup>

Owner

Geo. F. Pearson


Am't. Paid \$ #17.00

Address

81 Audubon Rd.

Builder \_\_\_\_\_

Boston, Mass.

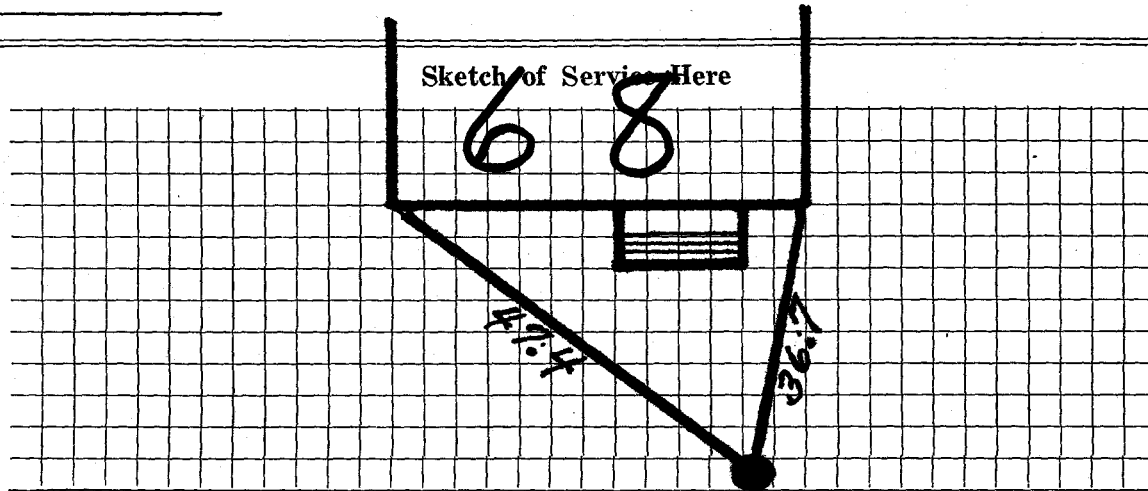

Connection made in \_\_\_\_\_ Street.

Work completed \_\_\_\_\_ 19

Remarks: