

Name Howard O. McMahon

Service No. 44

Address 72 Shade Street

Lexington, Mass.

Location 72 Shade Street

Kind of Pipe

Size

Size of Main

Repair—Renewal—New Service

Com. 5-29-50

Location

Date	Material	Amount	Total	Date	Amount
May 2, '50	Labor	10 60	10 60	April 4 '50	275 00
	10% Overhead		1 06	Revised 4 '50	144 35
	350' - 1" Copper Tubing @.284		99 40		130 65
	1 - 1" C x 1" I.W.H. S&W		3 29		No Charge
	8 - 1" C x 1" C Union (3pts)		14 80	May 2, '50	Labor
	Trucking 2 hrs. @.75		1 50		39 05
			130 65	42' - 1" Copper Tubing @.284	11 93
				1 - 1" C Corp-cock	4 62
				1 - 1" C x 1" C Curb-cock	5 60
				1 - Box & Rod	3 60
				2 - 1" Straight Tail Pieces @.93	1 86
				Littlefield Shovel 4 hrs. @7.00	28 00
				Trucking 1 hr. @.75	75
				Patching 18 x 3	18 00
	Labor				113 41
				7/4/95 2' - 1" Copper	
				2 1" Miller Compressions	

DATE _____

TOWN OF LEXINGTON - BOARD OF PUBLIC WORKS

WATER DIVISION

The undersigned applies for a supply of water at No..... St. and hereby agrees to comply with the rules and regulations as now, or at any future time, established by the Board of Selectmen.

Am't of Estimate \$.....


Owner

Am't Paid \$.....

Address

Builder

Sketch of Service Here

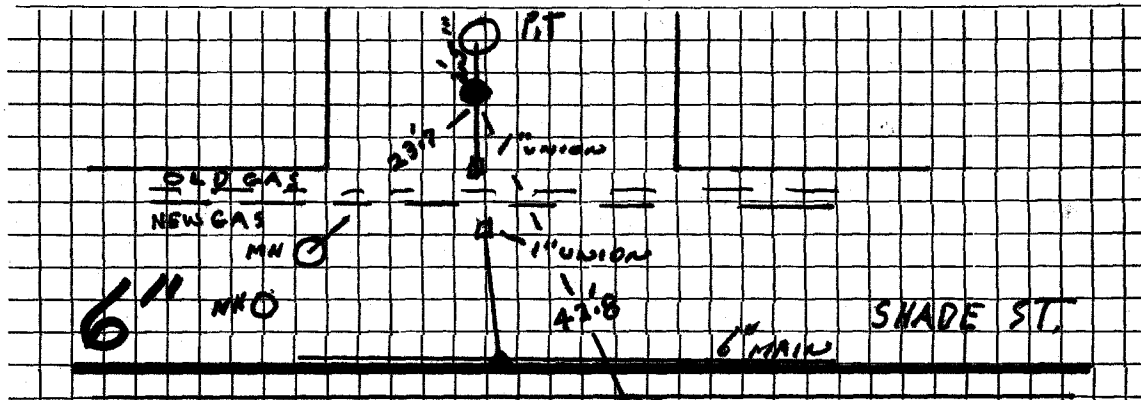

Connection made in Street.

87
20

Work completed19

Remarks: SERVICE UNDER OLD + NEW GAS MAIN