Name TH Shade St

Service No.

Address

Location


Repair (Renewal) New Service

		I. · ·	1	1	
Date	Material	Amount	Total	Date	Amount
2/27/24	1" copper pipe				
	1" curb stop				
	open-right				
	J				
	buffalo box				
				V	
_	Additional 1" copp	V			
	for potential connec	ction	* **		
	to future carriage	house.			
_	Includes shut off	inside			
	foundation of the	house.			
· X - 4.5					

Date: 2/27/24

TOWN OF LEXINGTON - BOARD OF PUBLIC WORKS WATER DIVISON

SKETCH OF SERVICE HERE 74 Shade St.

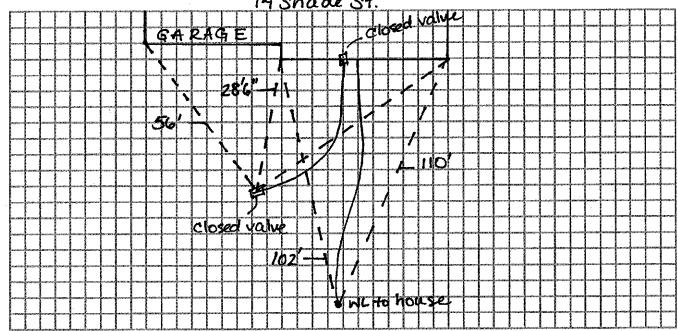

		·	
Connection made in:	Street.	Work completed:	
Remarks: Installed by SA	DCO		130000000
anninganinganganinganinganinganinganing	ОДОДА (АДИ) РУМИ И КИЕ И ИМ ИЕЕИ И ИЕИ ЛЯВЕГЛИ ИНИ ИТИРИ В РУГЛЯНДАР И ИТИРЕТ ИТИГИТЕТИ ИТИТИТЕТИ ИТИГИТЕТИ ИТИГИТЕТИ ИТИГИТЕТИ ИТИГИТЕТИ ИТИГИТЕТИ ИТИГИТЕТ	•	
эншилизирынык кажына кылым байын байын кылым айын айын айын айын айын айын айын айын	(A. II. II.) 1848 1848 18 18512 18 1855 1831 18 18 18 18 18 18 18 18 18 18 18 18 18	аштуунин тороон жана жана жана жана жана жана жана ж	,