


DATE 2018

TOWN OF LEXINGTON — BOARD OF PUBLIC WORKS

WATER DIVISION

Sketch of Service Here

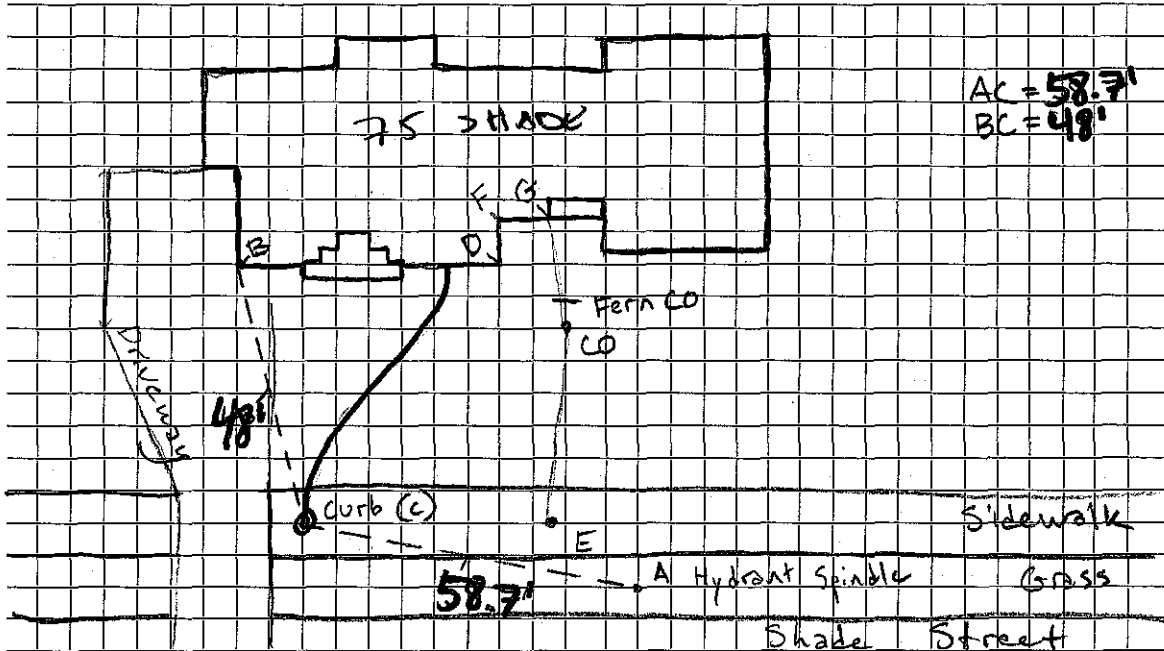

Connection made in Shade Street. Work completed

Remarks: ... Depth: 5.5" ... Existing was 1" curb. ... Installed new 1" curb, left old on.