


DATE _____

TOWN OF LEXINGTON — BOARD OF PUBLIC WORKS
WATER DIVISION

Sketch of Service Here

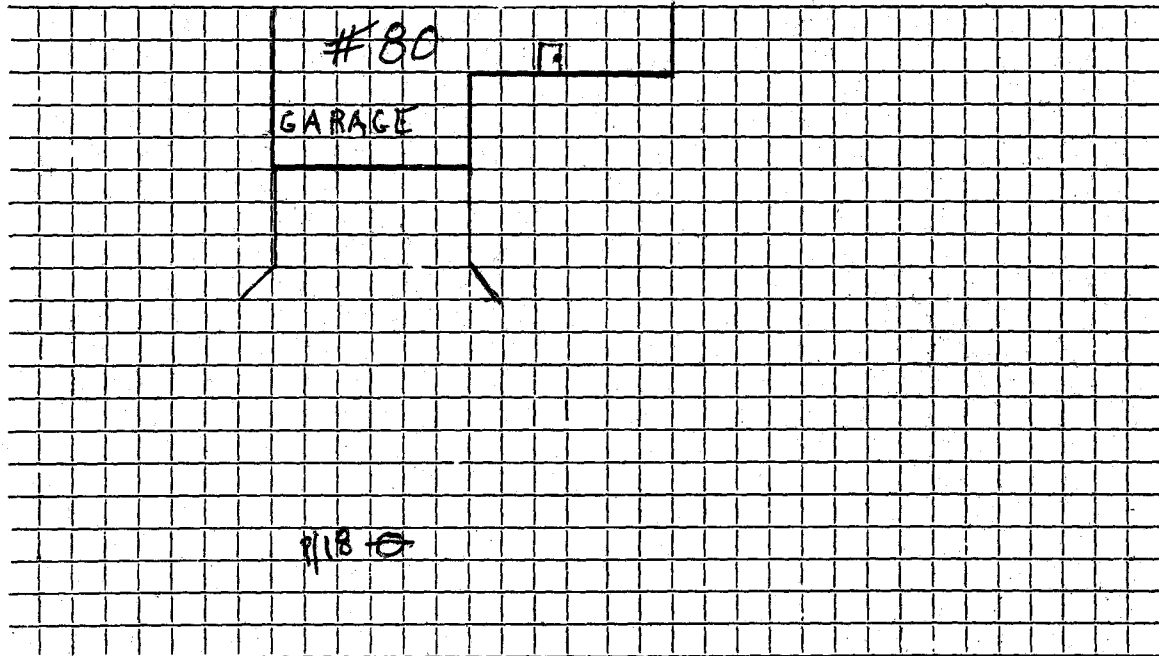

Connection made in Street. Work completed ..1962 X.....

Remarks: NEW House could not loc. 1/3/05.....