

WATER SERVICE RECORD

Name Charles McLaughlin

Service No. 274

Address 81 Shade Street

427

Location Lexington

~~Repair - Backflow~~ - New Service

Com. 11-24-52 / PERMIT 0931-MVF CONTRACTORS

Date	Material	Amount	Total	Date	Amount
10/22/52	Labor	1 80		10-20-52 Deposited	15 -
	10% overhead	18	1 98	11-24-52 Refunded	(8 27
	1 -3/4" C x 1/2 I.W.H. stop& waste	4 00	4 00	<u>NON CHARGE</u>	6 73
	1 hr. trucking		75	10/22/52 Labor	4 58
			6 73	5' - 3/4" copper tubing @ .34	1 70
	TRENCH DUG BY OWNER			1 -3/4" C corp-cock	4 33
	PIPE SUPPLIED & LAID BY OWNER			1 -3/4" C x 3/4" C curb-cock	4 67
				1 box and rod	3 90
				1 -1/2 offset tail piece	50
				1 -3/4 straight tail piece	50
				2 hrs. Littlefield shovel	14 00
				1 hr. trucking	75
					<u>34 93</u>

3/20/1997 84' - 1" φ COPPER
1 - UNION


3/20/1997 13' - 1" φ COPPER
1" CORPORATION

DATE MARCH 20, 1997

TOWN OF LEXINGTON — BOARD OF PUBLIC WORKS

WATER DIVISION

Sketch of Service Here

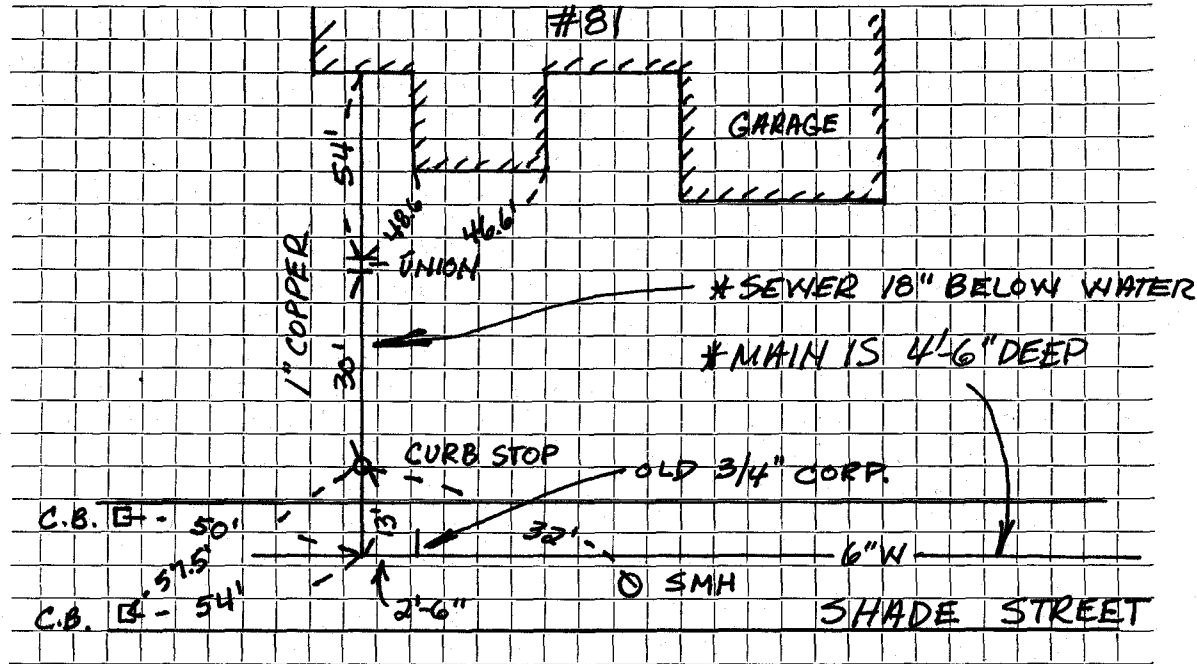

Connection made in SHADE STREET Street.

Work completed MVF CONTRACTORS

Remarks: