




DATE 3/26/18

TOWN OF LEXINGTON — BOARD OF PUBLIC WORKS

WATER DIVISION

Sketch of Service Here

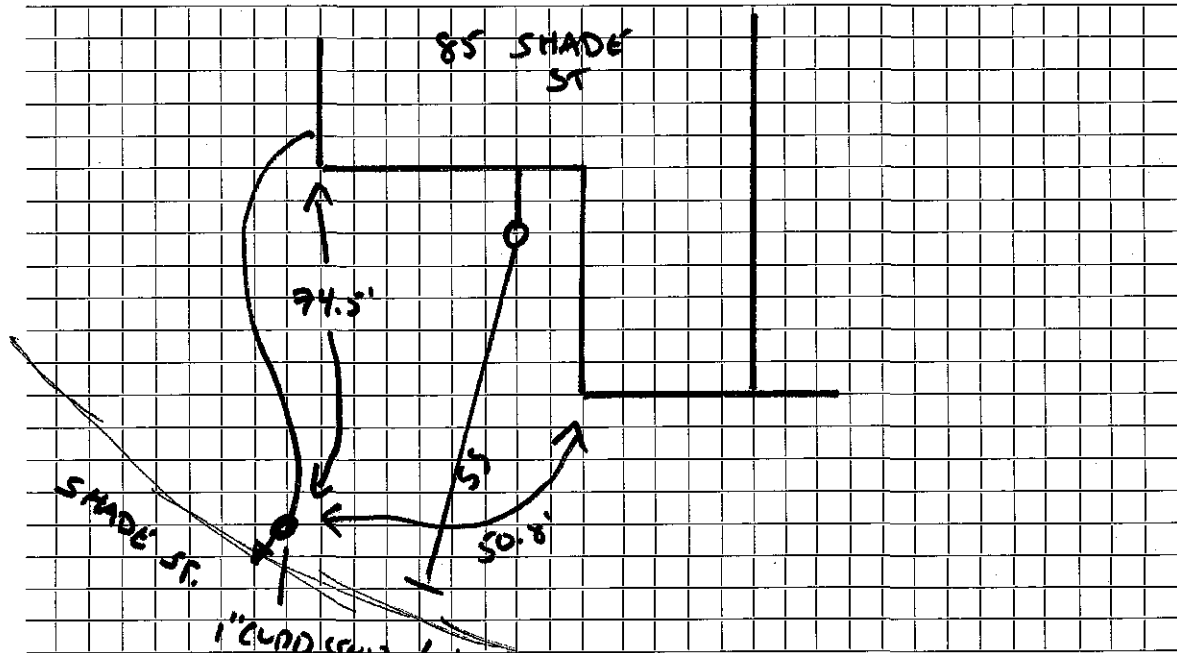

Connection made in (SHADE) Street. 1" CUPPL 1/2" couplings 4' DEPTH

Work completed ... LOVINO ... GRUMANN ...

Remarks: .....