

Name **Helmar C. Anderson**

Service No. ~~40~~ **2421**

Address **31 Brooks Avenue, Arlington, Mass.**

**2767**

**9 Shade St.**

Location

**9 Shade Street**

Kind of Pipe

Size

Size of Main

Repair—Renewal—New Service

Location

Date  
1939

Material

Amount

Total

Date

Amount

Sept. 27

6 hrs. @ 60¢

3 60

September 25, 1939 Deposited

25 00

10 % Overhead

36

3 96

December 2, 1939 Paid 7.33

2 33

42' 3/4" Copper tubing @ 15¢

6 30

1 3/4" C.x 1/2" S.& W.

2 00

1 hrs. trucking

75

Trench repairs

14 22

27 33

11/3/39 Bell sent 7.33

Labor

DATE Sept. 21, 1935

# TOWN OF LEXINGTON - BOARD OF PUBLIC WORKS

## WATER DIVISION *Lot 36.*

The undersigned applies for a supply of water at No. 9 Shade St. and hereby agrees to comply with the rules and regulations as now, or at any future time, established by the Board of Selectmen.

Am't. of Estimate \$ 21<sup>00</sup>

Owner

Helmer P. Anderson

Am't. Paid \$ \_\_\_\_\_


Address

31 Brooks Ave

Builder \_\_\_\_\_

Arlington Mass.

Sketch of Service Here

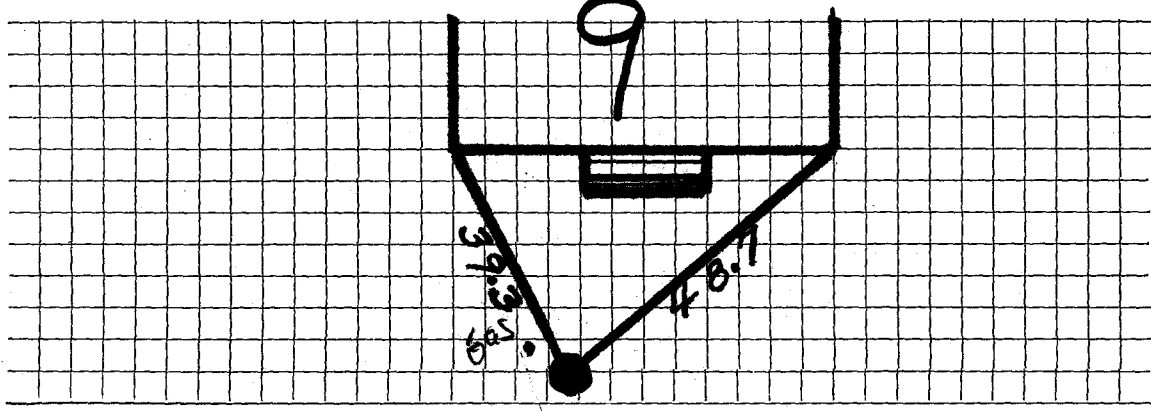

Connection made in \_\_\_\_\_ Street.

Work completed \_\_\_\_\_ 19

Remarks:

*655 1 foot from curb*