


DATE _____

TOWN OF LEXINGTON — BOARD OF PUBLIC WORKS
WATER DIVISION

Sketch of Service Here

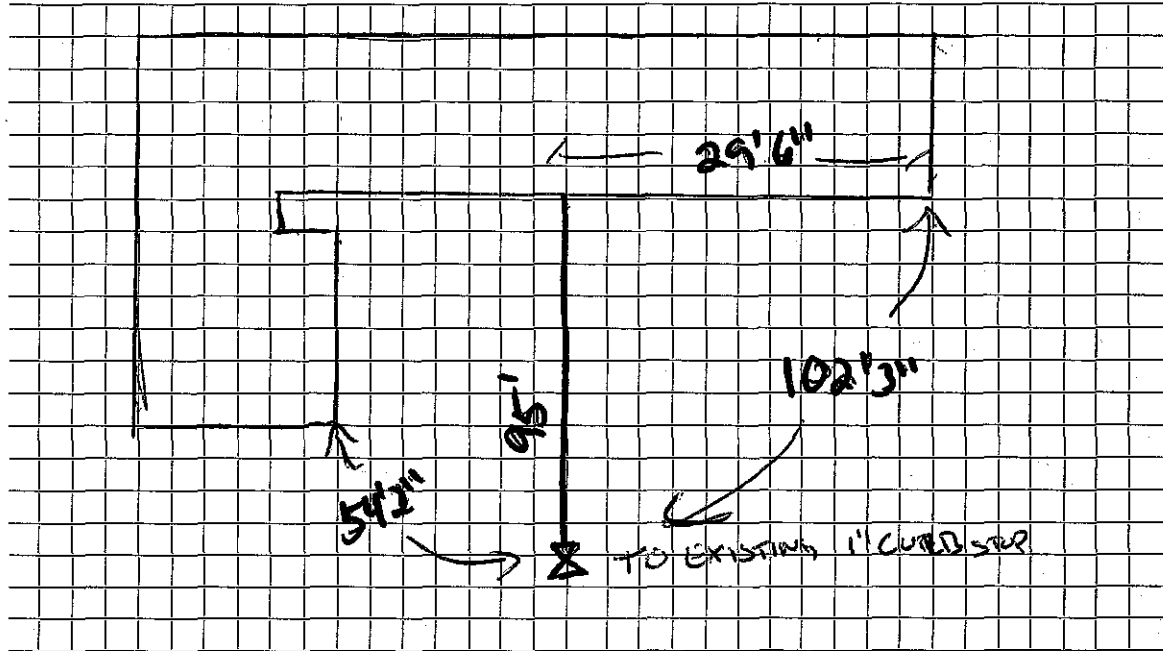

Connection made in SHADE Street. Work completed Jim McLoughlin

Remarks: _____

