

WATER SERVICE RECORD

Name *BUSA REALTY TRUST*

Service No.

Address *3 SHEILA RD*

Location


Repair—Renewal—New Service *DAVE EAGLE # PERMIT A 254*

Date	Material	Amount	Total	Date	Amount
4-27-66	45' 3/4 COPPER			1966	3/4 COP 3/4 CURB STOP 3/4 COPPER BOX & ROD
10-31-91	REPAIR CONT.				
	2 3/4 COMP UNIONS				
	6.5" 3/4 COPPER				

TOWN OF LEXINGTON — BOARD OF PUBLIC WORKS

WATER DIVISION

Sketch of Service Here

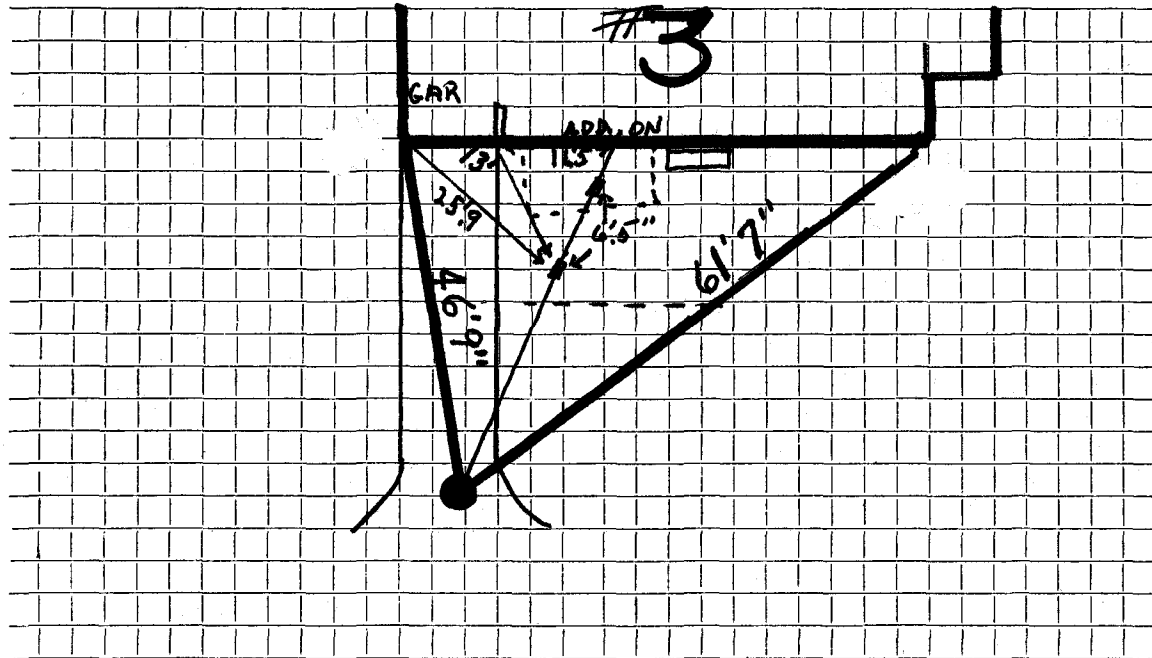

Connection made in ..... Street. Work completed .....

Remarks: 1 Union UNDER NEW ADD ON, 5'5" From old outside wall. 1 Union outside NEW ADD ON.