

Name Nelson C. Scroggin

Service No. 146

Address 10 Sherburne Road

Lexington, Mass.

Location 10 Sherburne Road

Kind of Pipe

Size

Size of Main

~~RENEWAL~~ New Service

Com. June 7, 1948

Location

Date	Material	Amount	Total	Date	Amount
Mar. 29, '48	Labor	1 90		Oct 15 '47	35 00
30	"	2 68	4 58	June 10 '48	1 60
	10% Overhead		46		83 40
	41' - 3/4" Copper Tubing @.255	10 46			
	1 - 3/4" C x 1/2" I.W.H. S & W	3 15		Mar. 30, '48	2 05
	Littlefield Shovel 2 hrs. @7.00	14 00		9' - 3/4" Copper Tubing @.255	2 30
	Trucking 1 hr. @.75		75	1 - 3/4" C Corp-cock	3 00
			33 40	1 - 3/4" C x 3/4" C Curb-cock	3 68
				1 - Box & Rod	3 50
				Littlefield Shovel 1 hr. @7.00	7 00
				1 - 1/2" Offset Tail Piece	30
				1 - 1/2" Straight Tail Piece	30
				Trucking 1 hr. @.75	75
	Labor				22 88

DATE _____

TOWN OF LEXINGTON - BOARD OF PUBLIC WORKS

WATER DIVISION

The undersigned applies for a supply of water at No..... St. and hereby agrees to comply with the rules and regulations as now, or at any future time, established by the Board of Selectmen.

Am't of Estimate \$.....


Owner

Am't Paid \$.....

Address

Builder

Sketch of Service Here

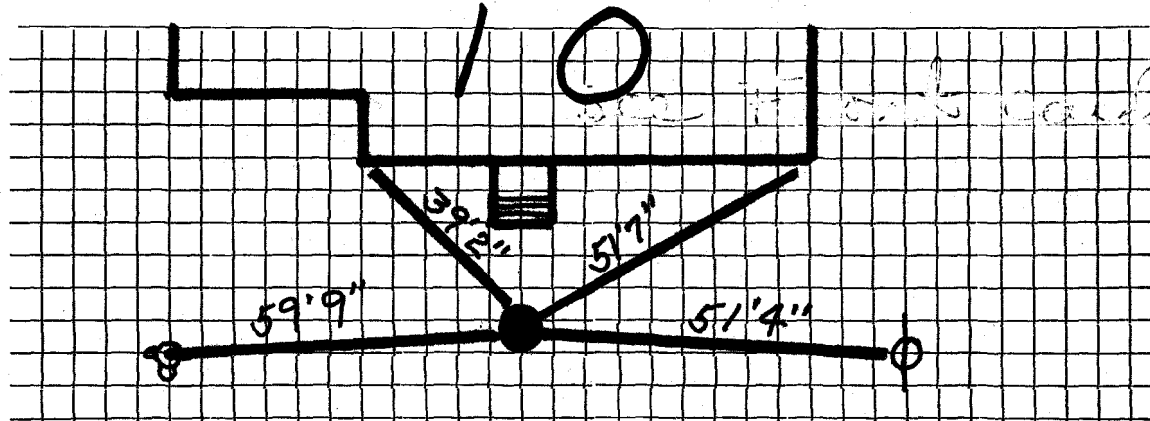

Connection made in Street.

Work completed19

Remarks: