

Name Joseph Lato

Service No. # 828

Address 17 Sherburne Road

Lexington, Mass.

Location 17 Sherburne Road

Kind of Pipe

Size

Size of Main

~~REPAIR WORK~~ - New Service

Com. 7-5-49

Location

Date	Material	Amount	Total	Date		Amount
May 27, '49	Labor	4 10	4 10	May 25 '49	Disputed	50 00
	10% Overhead		41	July 6 '49	Expanded	15 93
	148' - 3/4" Copper Tubing @.24		11 52		Non-Charge	34 07
	1 - 3/4" C x 1/2" I.W.H. S&W		3 29	May 27, '49	Labor	4 10
	Shovel 2 hrs. @ 7.00		14 00	14' - 3/4" Copper Tubing @.24		3 36
	Trucking 1 hr. @.75		75	1 - 3/4" C Corp-cock		3 15
			34 07	1 - 3/4" C x 3/4" C Curb-cock		3 85
				1 - Box & Rod		3 95
				1 - 1/2" Offset Tail Piece		37
				1 - 1/2" Straight Tail Piece		37
				Shovel 1 hr. @.7.00		7 00
				Trucking 1 hr. @.75		75
	Labor					26 90

TOWN OF LEXINGTON - BOARD OF PUBLIC WORKS

WATER DIVISION

The undersigned applies for a supply of water at No..... St. and hereby agrees to comply with the rules and regulations as now, or at any future time, established by the Board of Selectmen.

Am't of Estimate \$.....

Owner


Am't Paid \$.....

Address

Builder

.....

Sketch of Service Here

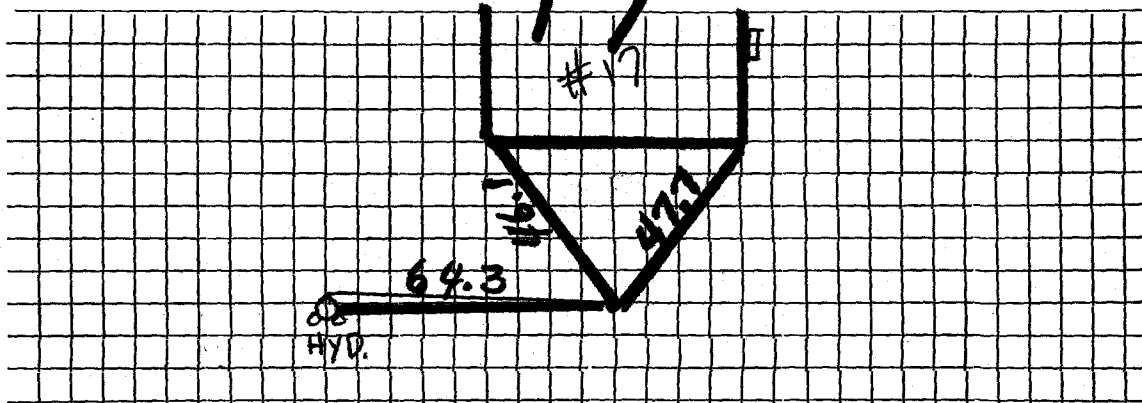

Connection made in Street.

Work completed19

Remarks: