

Name William Szczerbinski

Service No. 49

Address 20 Sherburne Road

Lexington, Mass.

Location 20 Sherburne Road

Kind of Pipe

Size

Size of Main

~~Repairs Renewal~~—New Service

Com. 5/22/50

Location

Date	Material	Amount	Total	Date	Amount
Apr. 10, '50	Labor	2 45	2 45	April 10 '50	60 00
	10% Overhead		25	May 22 '50	11 75
	51' - 3/4" Copper Tubing @.23	11 73			48 25
	1 - 3/4" C x 1/8" I.W.H. S&W	3 29		Apr. 10, '50	7 35
	2 - 3/4" C x 3/4" C Uniond (3pts)	2 78		45' - 3/4" Copper Tubing @.23	10 35
	Littlefield Shovel 1 hr. @ 7.00	7 00		1 - 3/4" C Corp-cock	3 15
	Trucking 1 hr. @.75		75	1 - 3/4" C x 3/4" C Curb-cock	3 85
	Patching 20 x 3		20 00	1 - Box & Rod	3 70
			48 25	1 - 1/2" Offset Tail Piece	38
				1 - 1/2" Straight Tail Piece	38
				Littlefield Shovel 3 1/2 hrs. @ 7.00	24 50
				Trucking 1 hrs. @ .75	75
	Labor				54 41

DATE \_\_\_\_\_

TOWN OF LEXINGTON – BOARD OF PUBLIC WORKS

**WATER DIVISION**

The undersigned applies for a supply of water at No..... St. and hereby agrees to comply with the rules and regulations as now, or at any future time, established by the Board of Selectmen.

Am't of Estimate \$.....

Owner .....


Am't Paid \$.....

Address .....

Builder .....

.....

Sketch of Service Here

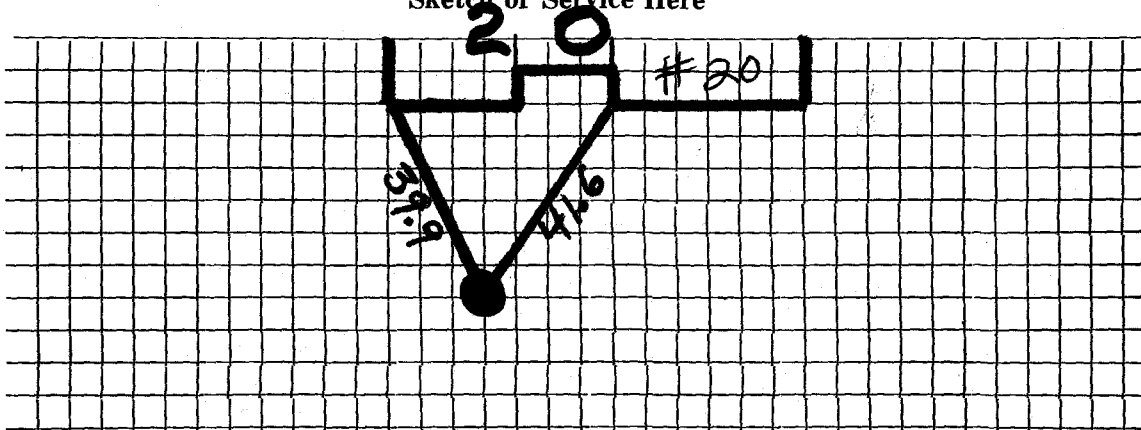

Connection made in ..... Street.

Work completed .....19

Remarks: