

3274

94

Name Kelley Corp.

Service No.

3348

Address ³² Sherburne Road

#3853

Texington, Mass.

Location ~~24~~ Sherburne Road

Kind of Pipe

Size

Size of Main

~~Repair~~ ~~Renewal~~ New Service

Location

Date	Material	Amount	Total	Date	Amount
Aug. 27, '47	Labor	2 20	2 20	Aug 20, '47	25 00
	10% Overhead		22	Sept 25, '47	15 68
	1 - 3/4" C x 1/2" I.W.H. S & W		3 15		9 32
	Shovel 1 hr. @ 3.00		3 00	Aug. 27, '47	2 20
	Trucking 1 hr. @ .75		75	55' - 3/4" Copper Tubing @ .28	15 40
			9 32	1 - 3/4" C Corp-cock	3 00
	Copper Tubing supplied by owner			1 - 3/4" C x 3/4" C Curb-cock	3 68
				1 - Box & Rod	4 26
				1 - 1/2" Straight Tail Piece	30
				1 - 1/2" Offset Tail Piece	30
				Shovel 1 hr. @ 3.00	3 00
				Trucking 1 hr. @ .75	75
	Labor				32 89

Deposited
Refunded
Non-Charge

DATE _____

TOWN OF LEXINGTON - BOARD OF PUBLIC WORKS

WATER DIVISION

The undersigned applies for a supply of water at No..... St. and hereby agrees to comply with the rules and regulations as now, or at any future time, established by the Board of Selectmen.

Am't of Estimate \$.....

Owner


Am't Paid \$.....

Address *34 Appleton St Lexington*

Builder

.....

Sketch of Service Here

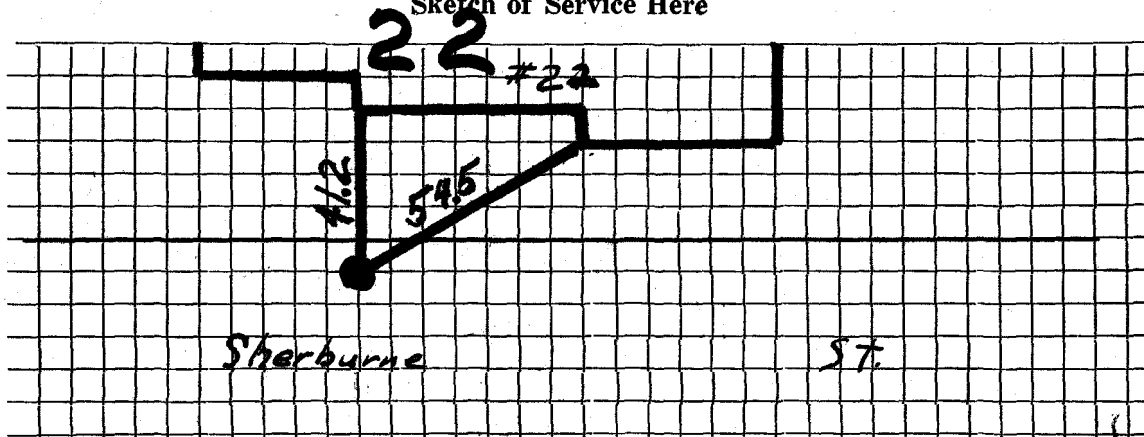

Connection made in Street.

Work completed19

Remarks: