

Name Francis E. Bandzril

Service No. <sup>#3349</sup>  
109

Address 25 Sherburne Road

Location 25 Sherburne Road

Kind of Pipe

Size

Size of Main

~~REPAIR WORK~~ New Service

Com. 8-15-49

Location

Date	Material	Amount	Total	Date	Amount
June 29, '49	Labor	4 80	4 80	June 16, 49 Deposited	60 00
	10% Overhead		48	Aug 20 49	4 80
	49' - 3/4" Copper Tubing @.24	11 76			55 08
	1 - 3/4" C x 1/2" I.W.H. S&W	3 29		June 29, '49 Labor	4 80
	Littlefield Shovel 1 hr.	7 00		35' - 3/4" Copper Tubing @.24	8 40
	Hough Loader 1 hr.	3 00		1 - 3/4" C Corp-cock	3 15
	Trucking 1 hr.	75		1 - 3/4" C x 3/4" C Curb-cock	3 85
	Patching 24 x 3	24 00		1 - 3/4" C x 3/4" C Union	1 39
		55 08		1 - Box & Rod	3 95
				1 - 1/2" Offset Tail Piece	37
				1 - 1/2" Straight Tail Piece	37
				Littlefield Shovel 1 hr.	7 00
	Labor			Hough Loader 1 hr.	3 00
				Trucking 1 hr.	75
					37 05

DATE \_\_\_\_\_

TOWN OF LEXINGTON - BOARD OF PUBLIC WORKS

**WATER DIVISION**

The undersigned applies for a supply of water at No..... St. and hereby agrees to comply with the rules and regulations as now, or at any future time, established by the Board of Selectmen.

Am't of Estimate \$.....

Owner .....


Am't Paid \$.....

Address .....

Builder .....

.....

Sketch of Service Here

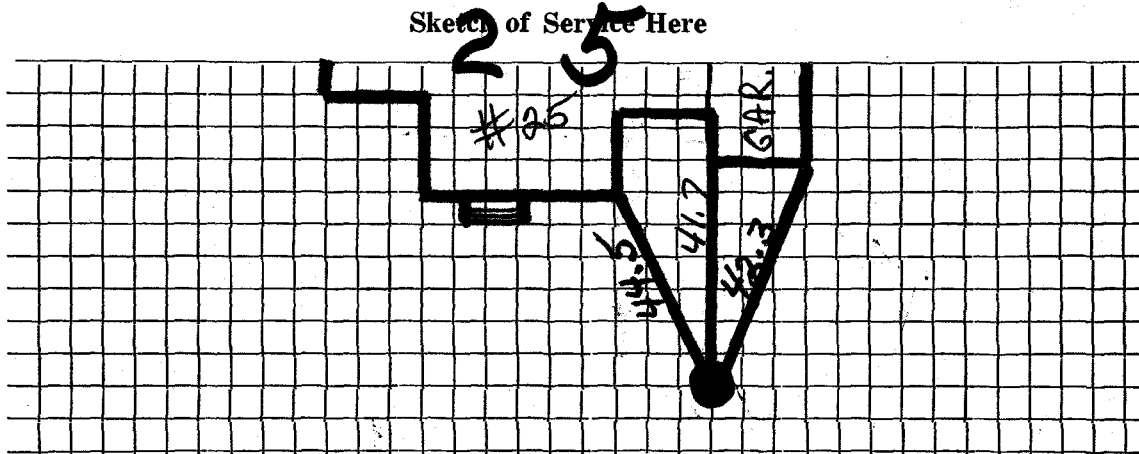

Connection made in ..... Street.

Work completed .....19

Remarks: