

WATER SERVICE RECORD

Name *26* Richard Magnanti

Service No. 277

Address ~~22~~ Sherburne Road

Location

~~Repair - Renewal~~ - New Service

Comm 2-8-60

Date	Material	Amount	Total	Date	Amount
10-28-59	Labor	2 10		<i>10-22-59</i>	<i>Deposit</i> 25 00
	10% O. H.	21	2 31	<i>2-8-60</i>	<i>Paid by SHCTF 214</i> 21 45
72'	3/4" Copper tubing @.42		30 24		46 45
1	3/4" C x 1/2 I.W.H. Stop & Waste	5 88			NON CHARGE
1	Box & Rod		5 00	5-7-59	Labor 3.76
1	3/4" C 3 part Union		2 27		12' 3/4" Copper tubing@.3666 4.40
1	Hr. Trucking @.75		75		1 3/4" C Corp Cock 4.64
			46 45		1 3/4" C Curb Cock 6.03
					1 Box & Rod 5.00
					1 hr. Trucking @.75 75
					24 58
				10-28-59	1 1/2 Straight Tailpiece 50
					1 1/2 Offset Tailpiece 50
					25 58


DATE _____

TOWN OF LEXINGTON — BOARD OF PUBLIC WORKS

WATER DIVISION

Sketch of Service Here

See Sewer Canal

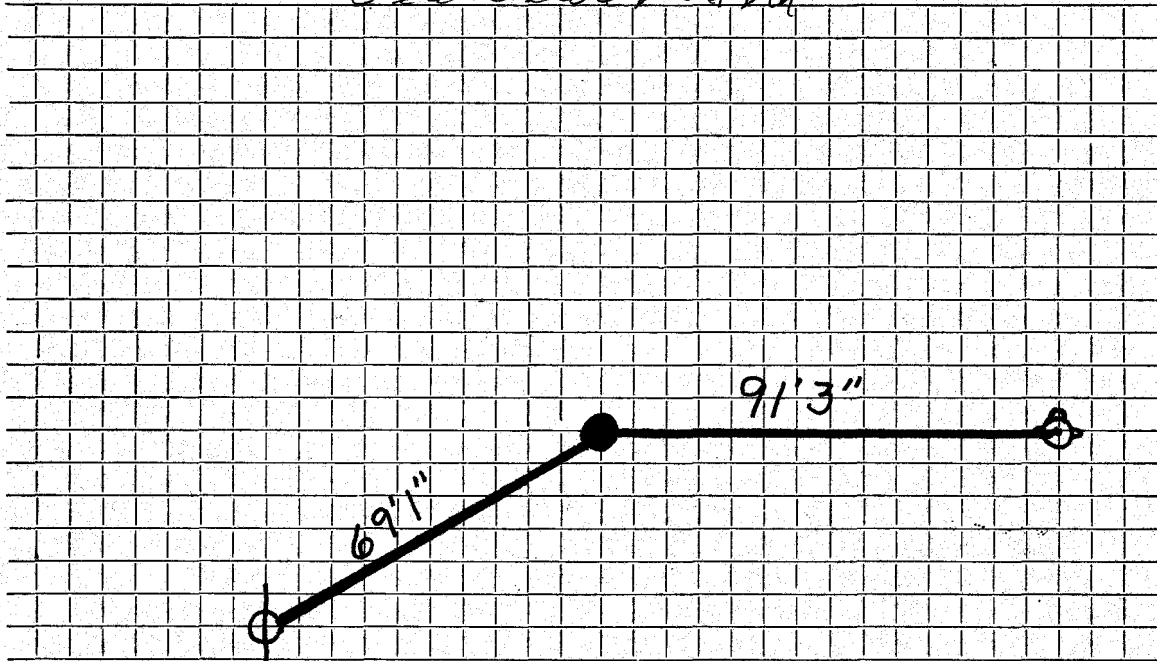

Connection made in Street. Work completed

Remarks:

.....

.....