

Name Henry B. Foster

Service No. 13 2724
#5570

Address 27 Sherburne Road

Lexington, Mass.

Location 27 Sherburne Road

Kind of Pipe

Size

Size of Main

~~XXXXXXXXXX~~ - New Service

Com. 5-29-50

Location

Date	Material	Amount	Total	Date	Amount
April 10, '50	Labor	2 45	2 45	Feb 2 '50	50 00
	10% Overhead		25		no additional bill rendered
	53' - 1" Copper Tubing @.284		15 05		No Charge
	1 - 1"C x 3/4" I.W.H. S&W		3 29	Apr. 10, '50	Labor 2 45
	1 - 1"C x 1"C Union (3pts)		1 85		35' - 1"C Copper Tubing @.284 9 94
	Littlefield Shovel 1 hr. @7.00	7 00	7 00		1 - 1"C Corp-cock 4 62
	Trucking 1 hr. @.75		75		1 - 1"C x 1"C Curb-cock 5 60
	Patching 20 x 3		20 00		1 - Box & Rod 3 60
			50 64		1 - 3/4" Offset Tail Piece 64
					1 - 3/4" S traight Tail Piece 64
					Littlefield Shovel 1 hr. @ 7.00 7 00
					Trucking 1 hr. @.75 75
	Labor				35 24

DATE _____

TOWN OF LEXINGTON - BOARD OF PUBLIC WORKS

WATER DIVISION

The undersigned applies for a supply of water at No..... St. and hereby agrees to comply with the rules and regulations as now, or at any future time, established by the Board of Selectmen.

Am't of Estimate \$.....

Owner


Am't Paid \$.....

Address

Builder

.....

Sketch of Service Here

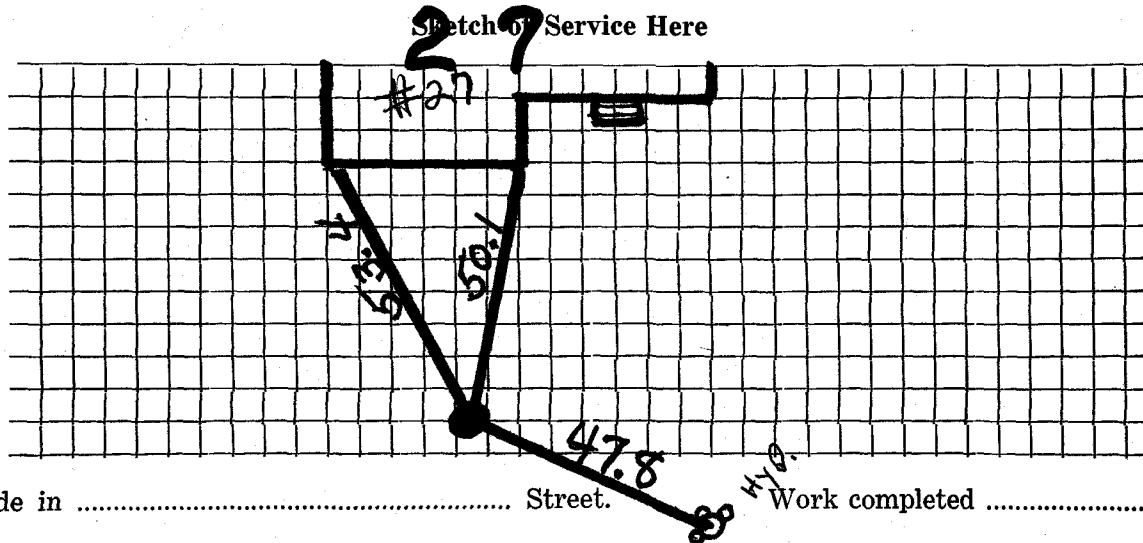

Connection made in Street. Work completed19

Remarks: