

WATER SERVICE RECORD

4461

Name **Walter Black**

Service No. 177

Address **29 Sherburne Road**

Location **Lexington Mass.**


~~REPAIR WORK~~ — New Service **Com. 10/1/51**

Date	Material	Amount	Total	Date	Amount
8-6-51	Labor	2 76	2 76	7-31-51 Deposited	50 00
	10% Overhead		28	10-1-51 Refunded & credited	11 17
	47'-3/4" Copper Tubing @.326	15 32	15 32	46 w.H.C.# 82	38 83
	1-3/4" Cx 1/2" I.W.H. S&W	4 00	4 00	No Charge	
	1-3/4" Cx 3/4" C Union (3 pts)	3 72	3 72	8-6-51 Labor	5 52
	2 Hr. Littlefield Shovel	14 00	14 00	30'-3/4" Copper Tubing @.326	9 78
	1 Hr. Trucking	75	75	1-3/4" C. Corp-Cock	4 33
			38 83	1-3/4" Cx 3/4" C Curb-Cock	4 67
				1- Box & Rod	4 68
				1- 1/2" Offset Tail Piece	50
				1- 1/2" Straight Tail Piece	50
				2 Hr. Littlefield Shovel	14 00
				1 Hr. Trucking	75
					44 73

DATE _____

TOWN OF LEXINGTON - BOARD OF PUBLIC WORKS
WATER DIVISION

Sketch of Service Here

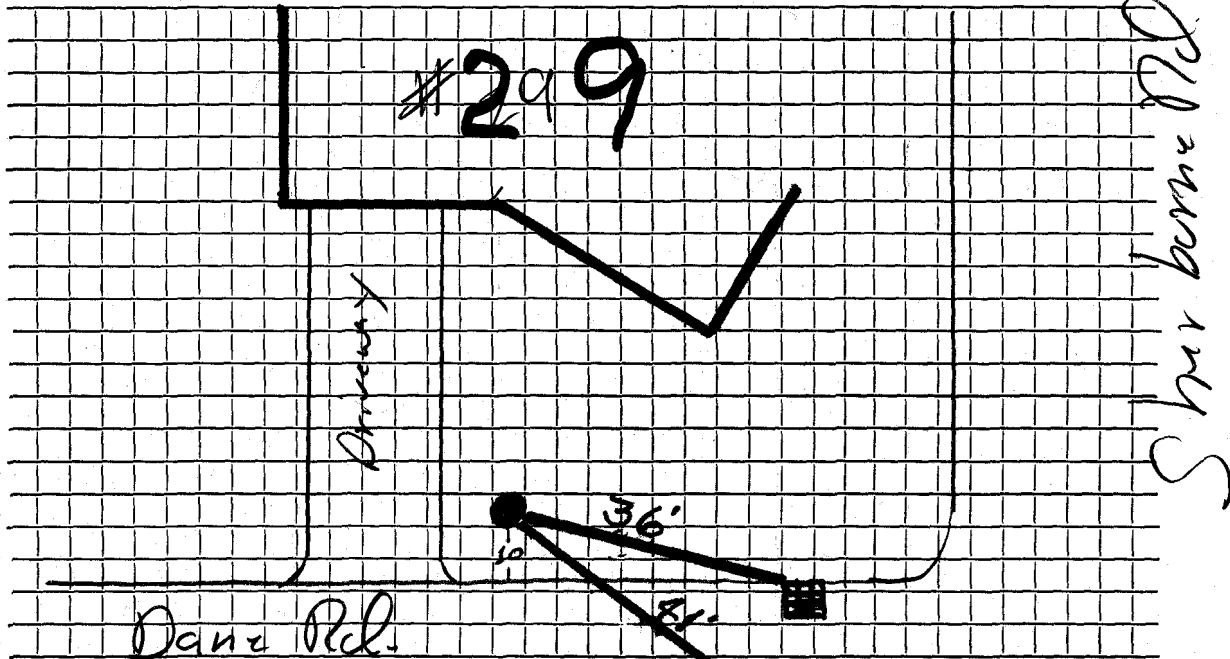

Connection made in Dane Rd. Street. Work completed

Remarks:
.....
.....