


DATE 3-22-2016

TOWN OF LEXINGTON — BOARD OF PUBLIC WORKS

WATER DIVISION

Sketch of Service Here

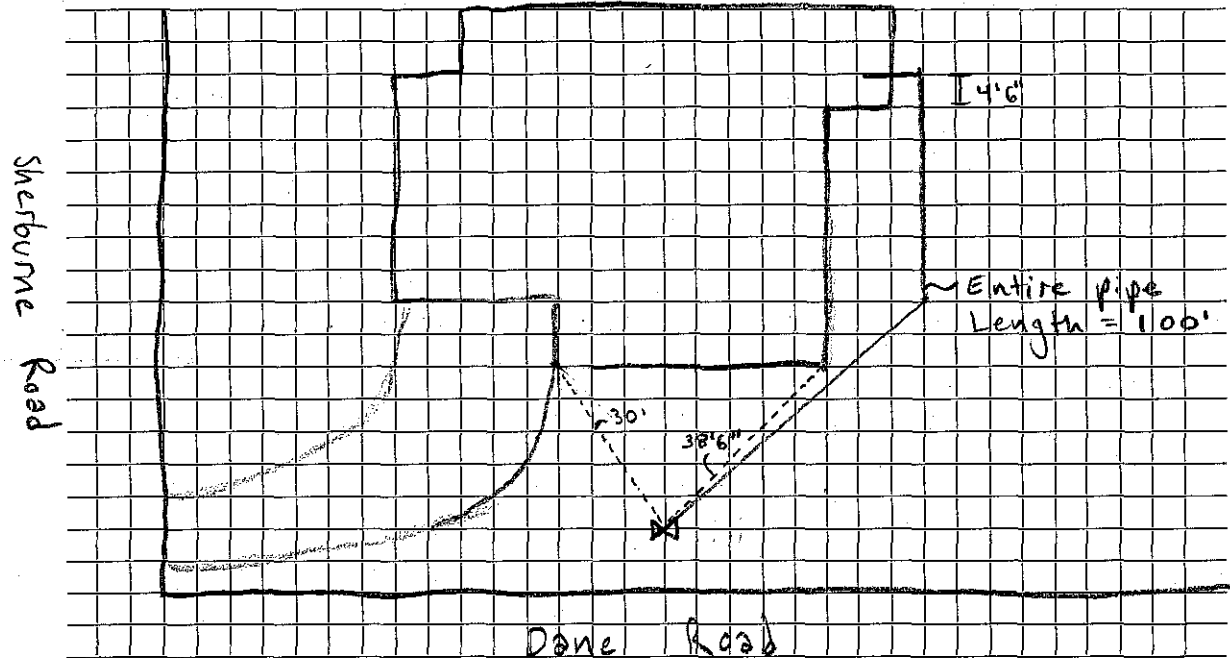

Connection made in Dane Road Street. Work completed

Remarks: Water connection from 33 Sherburne Rd is in Dane Rd