

WATER SERVICE RECORD

Name L. Zunghi & J. Tosti

Service No. 132

Address 3/4 Sherburne Road

#5874

Location Lexington, Mass.

~~Repair-Removal~~ - New Service

*Com. 9-24-51*


Date	Material	Amount	Total	Date	Amount
7-20-51	Labor	2 54	2 54	6-15-51 Deposited	50 00
	10% Overhead		25	9-24-51 Refunded	12 07
	1/5'-3/4" Copper Tubing @.326		14 67		37 93
	1-3/4"Cx1/2" I.W.H. S&W		4 00		No Charge
	1-3/4"Cx3/4"C Union (3 pts)		1 72	7-20-51 Labor	2 54
	2 Hr. Littlefield Shovel		14 00	9'-3/4" Copper @.326	2 93
	1 Hr. Trucking		75	1-3/4"C Corp-Cock	4 33
			37 93	1-3/4"Cx3/4"C Curb-Cock	4 67
				1 Box & Rod	4 68
				1-1/2" Offset Tail Piece	50
				1-1/2" Straight Tail Piece	50
				1 Hr. Littlefield Shovel	7 00
				1 Hr. Trucking	75
					27 90

DATE \_\_\_\_\_

# TOWN OF LEXINGTON — BOARD OF PUBLIC WORKS

## WATER DIVISION

Sketch of Service Here

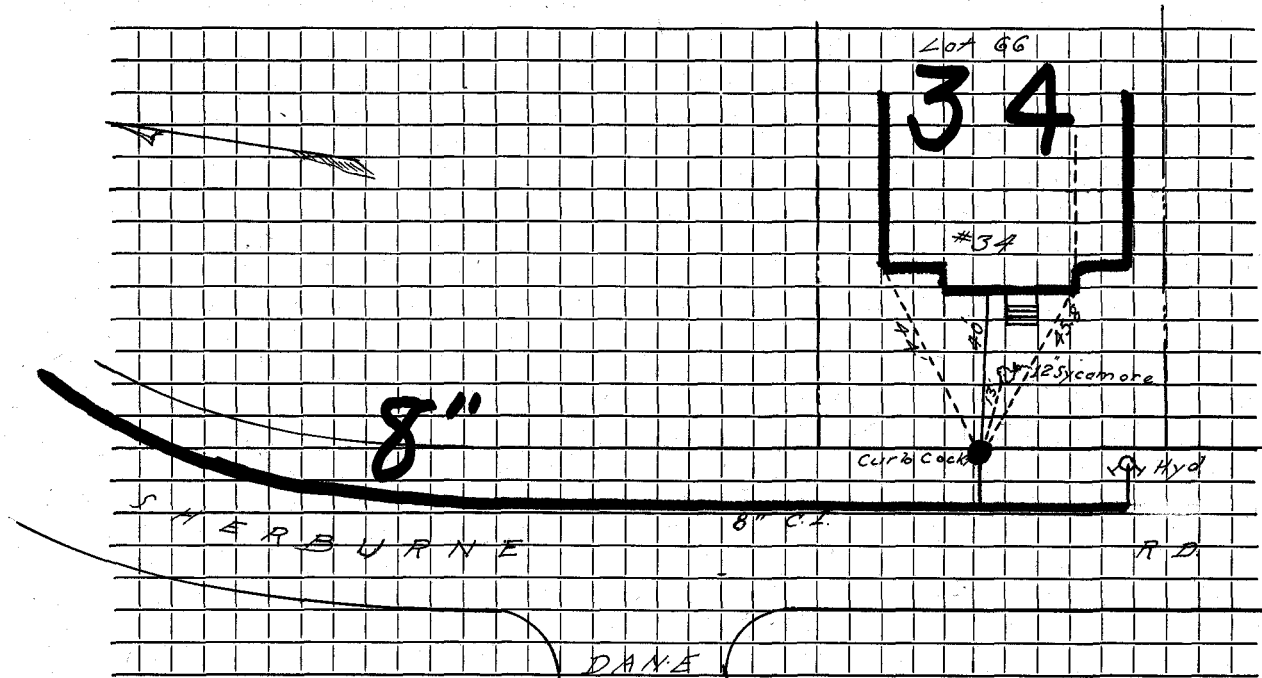

Connection made in ..... Street. Work completed .....

Remarks: .....  
.....  
.....