

#218

WATER SERVICE RECORD

Name Jeremiah DeMichaelis

Service No. 246

Address 35 Sherburne Road, Lexington

Location Mai Ito: 62 Billings Avenue, Medford

~~Repair~~ ~~Renewal~~ - New Service

Com. 11-21-55


Date	Material	Amount	Total	Date	Amount
8/12/55	Labor	19 67		7-29-55 Deposited	80 00
	10% Overhead	1 97	21 64	11-21-55 Refunded	(5 18)
	48'-3/4" Copper tubing @.384		18 43	Non Charge	74 82
	1-3/4" Cx 1/2" I.W.H. stop & waste	4 00	4 00	Labor	8 17
	4 hrs. Littlefield Shovel @ 7.50	30 00	30 00	8/12/55 22'-3/4" Coppertubing @.384	8 45
	1 hr. trucking @.75		75	1-3/4"x3/4" C.Curb cock	4 67
			74 82	1-3/4" C Corp cock	4 33
				1 Box & Rod	3 90
				1-1/2" offset tail piece	50
				1-1/2" straight tail piece	50
				1-1/3hrs. Littlefield Shovel @ 7.50	-10 00
					40 52

DATE \_\_\_\_\_

TOWN OF LEXINGTON — BOARD OF PUBLIC WORKS

WATER DIVISION

Sketch of Service Here

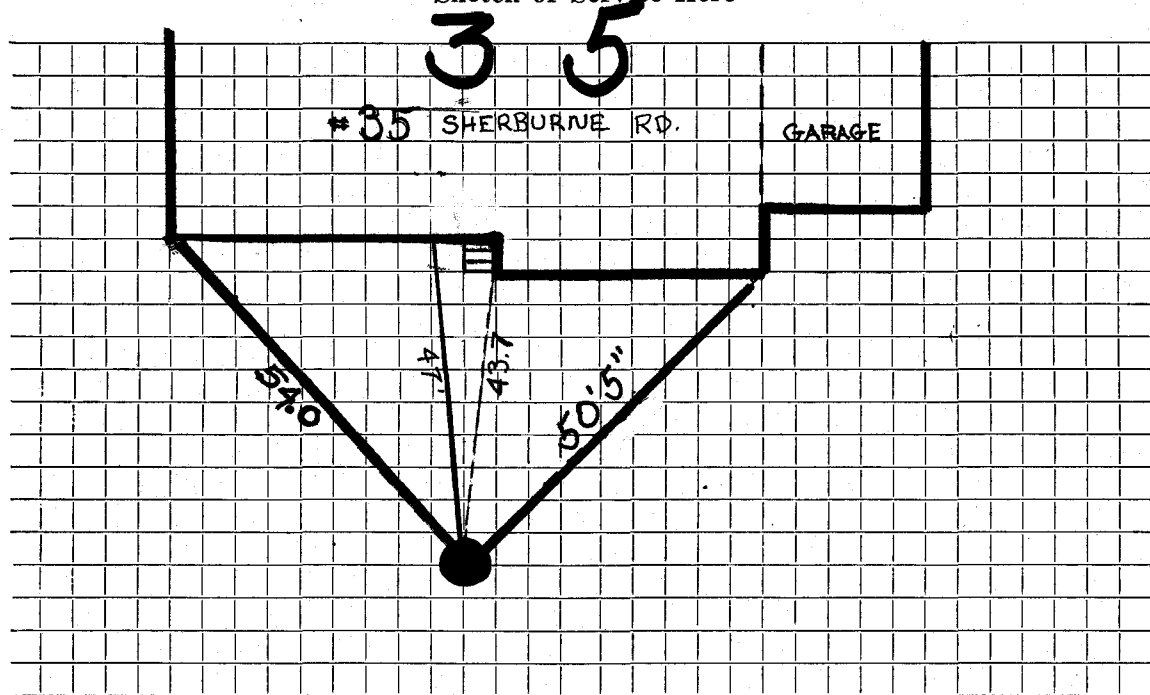

Connection made in ..... Street. Work completed .....

Remarks: .....

.....

.....