

WATER SERVICE RECORD

Name Louis Ciampa

Service No.

67

Address 39 Sherburne Road

3538

Location

~~Residence~~ New Service


Cont 2-5-60

Date	Material	Amount	Total	Date	Amount
5-17-60	Labor	1.94		5-10-60	Deposit 50.00
	10% O:H:	20	2.14	7-5-60	* Retard 20.69
50'	3/4" Copper tubing @.42		21.00		29.31
1	3/4" C x 1/2 I:W:H:Stop & Waste		6.17		NON CHARGE
			29.31	6-11-59	Labor 3.70
					28' 3/4" Copper tubing @.3764 10.54
					1 3/4" C Corp Cock 4.64
					1 3/4" C Curb Cock 6.07
					1 Box & Rod 5.00
					1 hr. Trucking @.75 .75
					30.70
					1 1/2 Straight tailpiece .50
					1 1/2 Offset tailpiece .50
					31.70
					* Applied to S.M.H. H

DATE _____

TOWN OF LEXINGTON — BOARD OF PUBLIC WORKS
WATER DIVISION

Sketch of Service Here

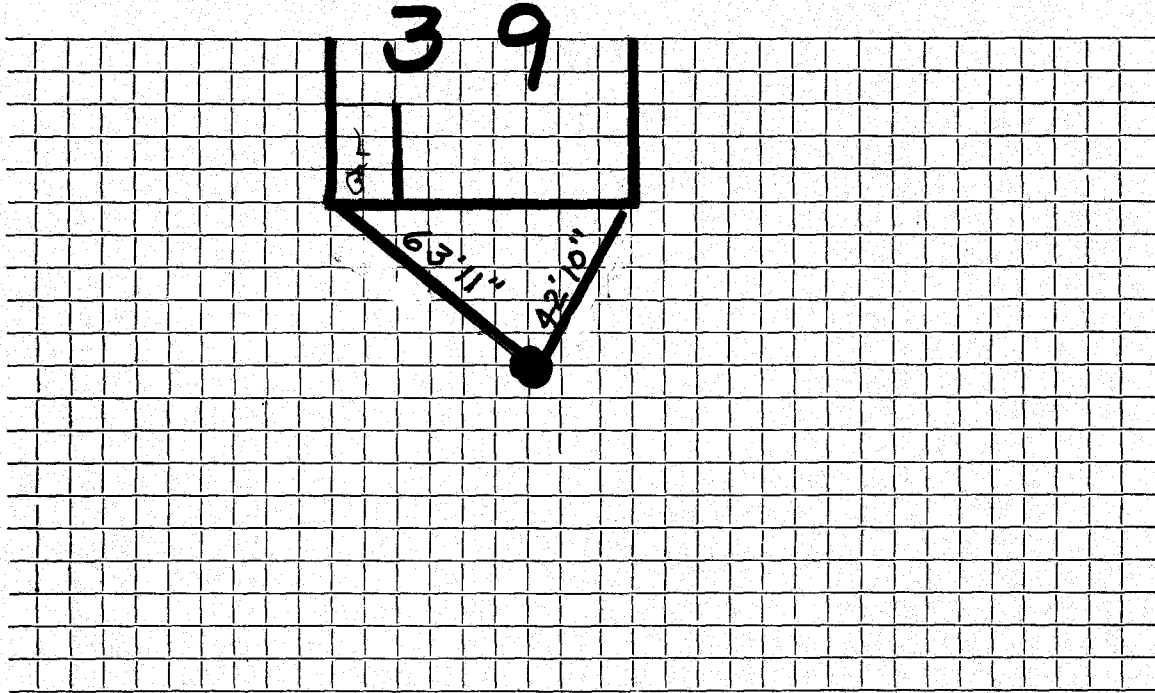

Connection made in Street. Work completed

Remarks:
.....
.....