

WATER SERVICE RECORD

3609

Name Louis Ciampa

Service No. 113

Address 40 Sherburne Road

Location

~~XXXXXX~~ - New Service


Comm 8-3-59

Date	Material	Amount	Total	Date	Material	Amount
6-11-59	Labor	1.85		6-5-59	Deposit	25.00
	10% O.H.	.19	2.04	8-3-59	Paid by SHC# 78	4.79
	50' 3/4" Copper tubing @.3764		18.82			29.79
	1 3/4" C x 1/2 I.W.H. Stop & Waste		5.88		NON CHARGE	
	1 3/4" C 3 part union		2.30		Labor	1.85
	1 hr. Trucking @.75		.75		10' 3/4" Copper tubing @.3764	3.76
			29.79		1 3/4" C Corp Cock	4.67
					1 3/4" C Curb Cock	6.07
					1 Box & Rod	5.00
					1 1/2 Straight tailpiece	.50
					1 1/2 Offset tailpiece	.50
						22.35

DATE _____

TOWN OF LEXINGTON — BOARD OF PUBLIC WORKS
WATER DIVISION

Sketch of Service Here

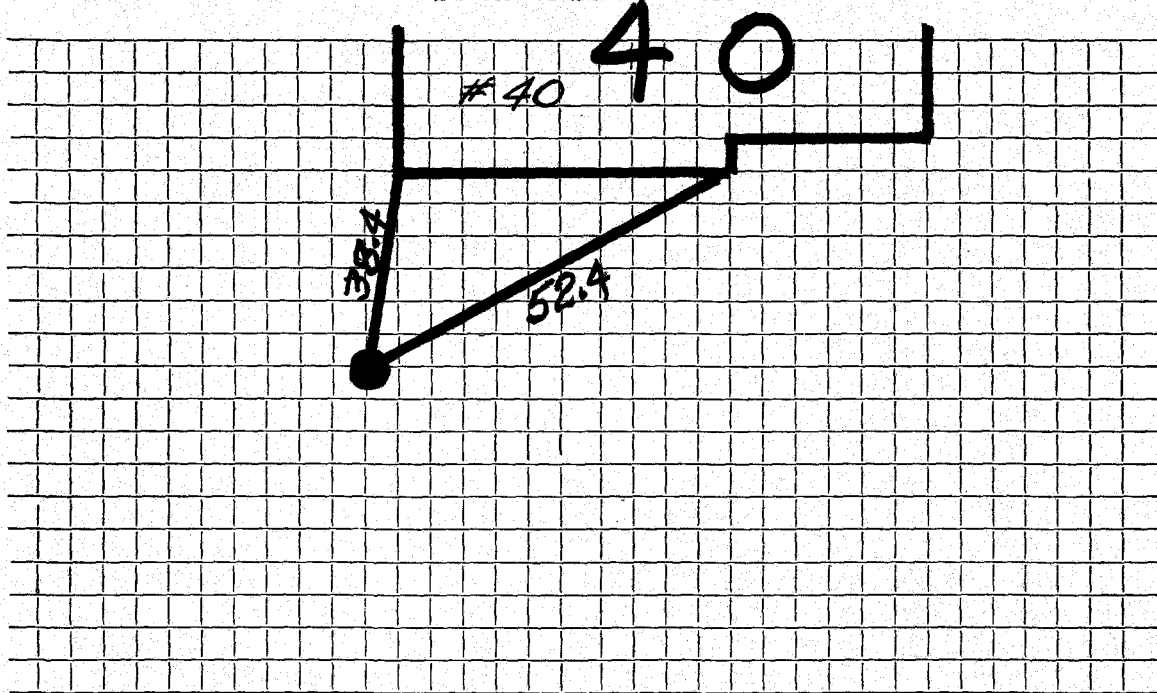

Connection made in Street. Work completed

Remarks:
.....
.....