

WATER SERVICE RECORD

Name Christos Fatouros

Service No. 26

Address #52 SHERBURNE RD.

Location Lot 24

~~Repair/General~~ - New Service

J. DEUIVE  
#3034

FEB 13 1978


Date	Material	Amount	Total	Date	Amount	
9/19/77	45' 1" COPPER			9-6-77	Deposit	32.34
8/22/60	Labor	1.94				
	10% O.H.	.19	2.13			
	7' 3/4" Copper tubing @.42		2.94			
			5.07		OUTSIDE	
			27.27	8-22-60	Labor	1.94
			32.34		22' 3/4" Copper tubing @.42	9.24
					1 3/4" Corp Cock	4.91
					1 3/4" Curb Cock	6.28
					1 Box & Rod	4.90
						27.27

DATE \_\_\_\_\_

TOWN OF LEXINGTON — BOARD OF PUBLIC WORKS

WATER DIVISION

Sketch of Service Here

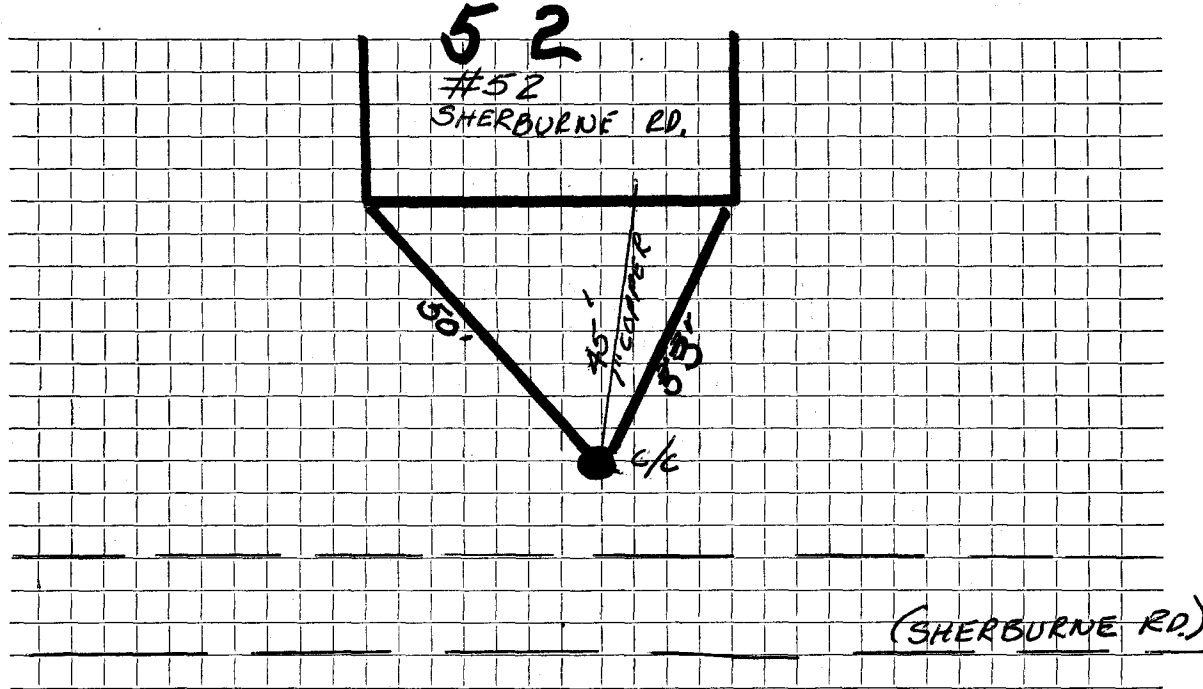

Connection made in SHERBURNE RD. Street. Work completed .....

Remarks: .....  
.....  
.....